

MISSISSIPPI DEPARTMENT OF NATURAL RESOURCES

Bureau of Land and Water Resources

Southport Mall

P.O. Box 10631

Jackson, Mississippi 39209

WATER WELL DRILLERS LOG

HARRISON

Q

2144

6-8  
date well completed

1995 McMillan Pumping Well  
firm name

Harrison  
county well located

LANDOWNER: Darryl McDonald

description of formations encountered

from

to

(mailing address)

WELL LOCATION:

sec. 18 T 8 N R 12 E  
5 miles N of Pass Christ  
(distance) (direction) (nearest town)

Mud	0	140
Mud/Sand	140	160
Mud	160	180
Mud/Sand	180	220
Mud	220	280
Mud/Sand	280	300
Sand	300	320

WELL PURPOSE:

(home, irrigation, municipal, industrial)

WELL COMPLETION DATA:

- (1) diameter (inches) 2"
- (2) total depth (feet) 320'
- (3) static water level (feet) 5' <sup>below</sup> <sub>above</sub> top of ground.
- (4) casing Sch. 40 PVC, 310'  
(material) (depth)  
         If telescope see back.  
(size)
- (5) screen 10' 310'  
(length) (depth to top)  
2" Sch. 80 PVC  
(size) (material)
- (6) pump 1 7  
(HP) (yield gpm)  
Elec  
(type power)
- (7) electric log           
(yes or no)  
          
(organization running log)
- (8) how well bottom plugged SAND  
SHARK


RECEIVED  
JUL 8 - 1995

Department of Natural Resources  
Bureau of Land & Water Resources

DRILLERS REMARKS:

If well telescopes please sketch and show depths.

GROUND LEVEL

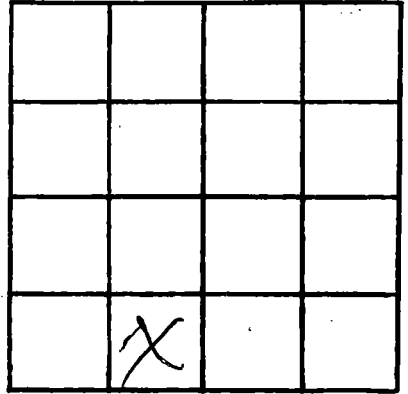

SECTION \_\_\_\_\_

Please indicate well location X.

ADDITIONAL INFORMATION

If more than one screen,  
show locations of each on sketch.