

MISSISSIPPI DEPARTMENT OF NATURAL RESOURCE.

Bureau of Land and Water Resources

Southport Mall

P.O. Box 10631

Jackson, Mississippi 39209

WATER WELL DRILLERS LOG

HARRISON
 Q 2146

7-1 1985 McMill Pump well Harrison
 date well completed firm name county well located

LANDOWNER: Alfred Dupree

260 Louisiana St.

Westwego, La.

(mailing address)

description of formations encountered

from

to

Sand

0 20

Mud/Sand

20 40

Mud

40 180

Mud/Sand

180 220

Sand

220 240

WELL LOCATION:

sec. 18 T. 8 N R. 12 E
 3 miles N of Pass Christ

(distance) (direction) (nearest town)

WELL PURPOSE:

(home, irrigation, municipal, industrial)

WELL COMPLETION DATA:

- (1) diameter (inches) 2"
- (2) total depth (feet) 240'
- (3) static water level (feet) 12' below top of ground.

- (4) casing 40 PVC, 230' (material) (depth)

(size) if telescope see back.

- (5) screen 10', 230' (length) (depth to top)

2" 80 PVC (size) (material)

- (6) pump N/A (HP) (yield gpm)

(type power)

- (7) electric log (yes or no)

(organization running log)

- (8) how well bottom plugged Sand Shale

DRILLERS REMARKS:


RECEIVED

AUG 20 1985

Department of Natural Resources
 Bureau of Land & Water Resources

If well telescopes please sketch and show depths.

GROUND LEVEL

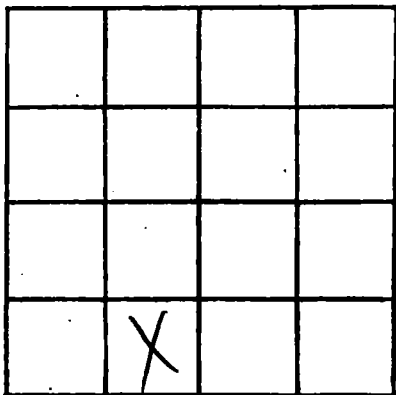

SECTION _____

Please indicate well location X.

ADDITIONAL INFORMATION

If more than one screen,
show locations of each on sketch.