

MISSISSIPPI DEPARTMENT OF NATURAL RESOURCES

Bureau of Land and Water Resources

Southport Mall

P.O. Box 10631

Jackson, Mississippi 39209

WATER WELL DRILLERS LOG

HARRISON  
 Q 2147

7-13  
 date well completed

85 Mc Hill Pump Well  
 firm name

Harrison  
 county well located

LANDOWNER: Robert K. Lewis

6 Morrow Dr.

Pass Christian  
 (mailing address)

WELL LOCATION:

sec. 18 T 8 N R. 12 E  
 2 miles N of Pass Christian  
 (distance) (direction) (nearest town)

WELL PURPOSE:  
 (home, irrigation, municipal, industrial)

WELL COMPLETION DATA:

- (1) diameter (inches) 2"
- (2) total depth (feet) 240'
- (3) static water level (feet) 4' below top of ground
- (4) casing 4" PVC, 230'  
 (material) (depth)

(size) if telescope see back.

- (5) screen 10' , 230'  
 (length) (depth to top)  
 2" Sch. 80 galv. PVC  
 (size) (material)

- (6) pump 1 / 8  
 (HP) (yield gpm)

ELEC.  
 (type power)

- (7) electric log (yes or no)

(organization running log)

- (8) how well bottom plugged SAND SEAL

description of formations encountered

from to

Sand / mud	0	20
Mud / sand	20	40
Mud	40	160
Sand / mud	160	180
Mud / sand	180	200
Mud / sand	200	220
Sand	220	240

RECEIVED


AUG 20 1985

DRILLERS REMARKS:

Department of Natural Resources  
 Bureau of Land & Water Resources

If well telescopes please  
sketch and show depths.

GROUND LEVEL

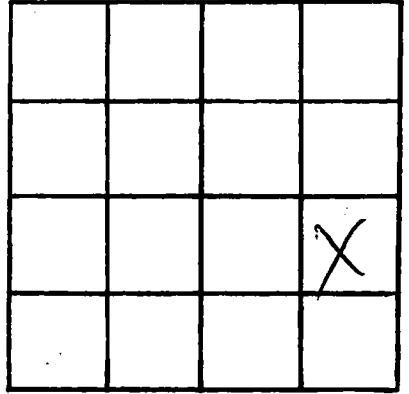

SECTION \_\_\_\_\_

Please indicate well location X.

ADDITIONAL INFORMATION

If more than one screen,  
show locations of each on sketch.