


**MISSISSIPPI DEPARTMENT OF NATURAL RESOURCES**  
**Bureau of Land and Water Resources**  
 Southport Mall  
 P.O. Box 10631  
 Jackson, Mississippi 39209  
**WATER WELL DRILLERS LOG**

*Harrison*  
  
 2148

Aug. 3 1983 *Duncan Well Drilling* *Harrison*  
 date well completed firm name county well located

LANDOWNER: *Jim Harley*  
*L.O. Box 9*  
*Long Beach Ms. 39560*  
 (mailing address)

| description of formations encountered | from       | to         |
|---------------------------------------|------------|------------|
| <i>clay</i>                           | <i>0</i>   | <i>18</i>  |
| <i>sand</i>                           | <i>18</i>  | <i>90</i>  |
| <i>Blue Clay</i>                      | <i>90</i>  | <i>480</i> |
| <i>fine sand</i>                      | <i>480</i> | <i>490</i> |
| <i>course sand</i>                    | <i>490</i> | <i>504</i> |

WELL LOCATION:  
 sec. 4 T. 48 N. R. 12 E.  
 (S) (W)  
2 miles W of Long Beach  
 (distance) (direction) (nearest town)

WELL PURPOSE:  
 (home, irrigation, municipal, industrial)

WELL COMPLETION DATA:

(1) diameter (inches) 2"

(2) total depth (feet) 504'

(3) static water level (feet) 20' below above top of ground.

(4) casing PVC, 494'  
 (material) (depth)

10' if telescope see back.  
 (size)

(5) screen 10', 494'  
 (length) (depth to top)

2", PVC  
 (size) (material)

(6) pump 1, 8  
 (HP) (yield gpm)

electric  
 (type power)

(7) electric log \_\_\_\_\_  
 (yes or no)

\_\_\_\_\_  
 (organization running log)

(8) how well bottom plugged and  
back

DEPT. OF NATURAL RESOURCES  
 BUREAU OF LAND & WATER RESOURCES


AUG 15 1983

**RECEIVED**

DRILLERS REMARKS:

If well telescopes please sketch and show depths.

GROUND LEVEL

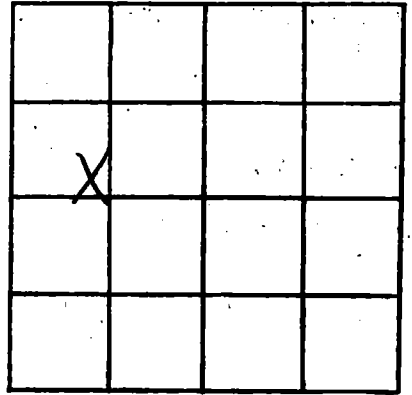

SECTION 4

Please indicate well location X.

ADDITIONAL INFORMATION

If more than one screen, show locations of each on sketch.