

MISSISSIPPI DEPARTMENT OF NATURAL RESOURCES

Bureau of Land and Water Resources

Southport Mall

P.O. Box 10631

Jackson, Mississippi 39209

WATER WELL DRILLERS LOG

Ø 2150
 HARRISON
 8-24-85

8-24-85 19 R. V. Moore HARRISON
 date well completed firm name county well located

LANDOWNER: R. M. LASSARIE
Feed Fridge R.D
Pineville MS
 (mailing address)

description of formations encountered	from	to
TOP SOIL	0	10
White Hblu clay	10	20
Grey Silt &	20	50
Blue clay	50	58
Coarse Gray Sand	560	612

WELL LOCATION:
 sec. 4 T. 8 N. R. 12 E
 (S) (W)
1 miles N of Pineville MS
 (distance) (direction) (nearest town)

WELL PURPOSE:
 (home, irrigation, municipal, industrial)

WELL COMPLETION DATA:

- (1) diameter (inches) 2"
- (2) total depth (feet) 612'
- (3) static water level (feet) 8 below above top of ground.
- (4) casing Pvc 412
 (material) (depth)
 (size) If telescope see back.
- (5) screen 10' #12
 (length) (depth to top)
2 Pvc
 (size) (material)
- (6) pump 1 12
 (HP) (yield gpm)
E
 (type power)
- (7) electric log yes or no
 (organization running log)
- (8) how well bottom plugged


RECEIVED
 OCT 10 1985

DRILLERS REMARKS:

Department of Natural Resources
 Bureau of Land & Water Resources

If well telescopes please sketch and show depths.

GROUND LEVEL

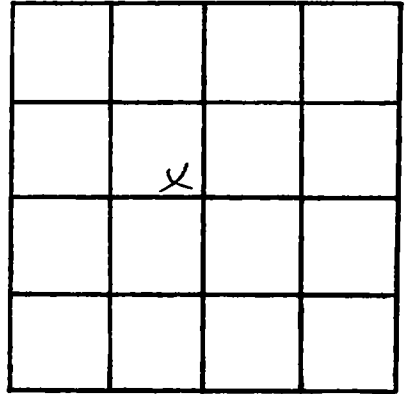

SECTION C1

Please indicate well location X.

ADDITIONAL INFORMATION

If more than one screen,
show locations of each on sketch.