

MISSISSIPPI DEPARTMENT OF NATURAL RESOURCES

Bureau of Land and Water Resources

Southport Mall

P.O. Box 10631

Jackson, Mississippi 39209

WATER WELL DRILLERS LOG

~~Stack~~  
 HARRISON  
 2157

Oct. 4

1985 Ward Well Dg.

Harrison

date well completed

firm name

county well located

LANDOWNER:

Fred Davis

210 Derrick Road

Pass Christian, ms.

(mailing address)

description of formations encountered

from

to

Sandy Soil

0

6

Clay

6

16

Sd

16

88

Sandy clay - silt

88

106

Sd

106

137

Sandy clay - silt

137

256

Fine Sd

256

280

Clay - silt

280

594

Coarse Sd

594

630

WELL LOCATION:

sec. 17 T. 8 N R. 12 E

6 miles N/E of Pass Christian

(distance)

(direction)

(nearest town)

WELL PURPOSE:

Home

(home, irrigation, municipal, industrial)

WELL COMPLETION DATA:

- (1) diameter (inches) 2"
- (2) total depth (feet) 630
- (3) static water level (feet) 21 <sup>below</sup> top of ground.

- (4) casing PVC 610 (material), (depth)

(size) If telescope see back.

- (5) screen 20' (length), (depth to top)

2" PVC (size), (material)

- (6) pump none (HP), (yield gpm)

(type power)

- (7) electric log NO (yes or no)

N/A (organization running log)

- (8) how well bottom plugged BWV

DRILLERS REMARKS: N/A


RECEIVED

NOV 20 1985

Department of Natural Resources  
 Bureau of Land & Water Resources

If well telescopes please sketch and show depths.

GROUND LEVEL

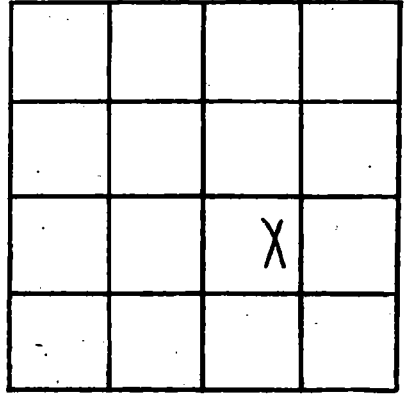

SECTION 17

Please indicate well location X.

ADDITIONAL INFORMATION

If more than one screen,  
show locations of each on sketch.