

MISSISSIPPI DEPARTMENT OF NATURAL RESOURCES

Bureau of Land and Water Resources

Southport Mall

P.O. Box 10631

Jackson, Mississippi 39209

WATER WELL DRILLERS LOG

HARRISON
 2152

11-2
 date well completed

1985 McMill Pump & Well

firm name

Harrison
 county well located

LANDOWNER: Peter McCarthy
213 Davis Ave.
Pass Christian, Ms.
 (mailing address)

WELL LOCATION:
 sec. 5 T. 8 N. R. 12 E.
6 miles N of Pass Christ.
 (distance) (direction) (nearest town)

WELL PURPOSE:
 (home, irrigation, municipal, industrial)

WELL COMPLETION DATA:

(1) diameter (inches) 2"

(2) total depth (feet) 400'

(3) static water level (feet) 50' ^{below}/_{above} top of ground.

(4) casing Sch. 40 PVC, 390'
 (material) (depth)

(size) if telescope see back.

(5) screen 10', 390'
 (length) (depth to top)

2", Sch. 80 PVC - 6 slot
 (size) (material)

(6) pump N/A
 (HP) (yield gpm)

(type power)

(7) electric log
 (yes or no)

(organization running log)

(8) how well bottom plugged SAND
SHARK


description of formations encountered	from	to
Mud	0	10
Sand	10	30
Mud	30	180
Sand	180	200
Mud	200	220
Sand	220	230
Mud	230	360
Sand	360	400

DRILLERS REMARKS:

RECEIVED
 NOV 26 1985

If well telescopes please sketch and show depths.

GROUND LEVEL

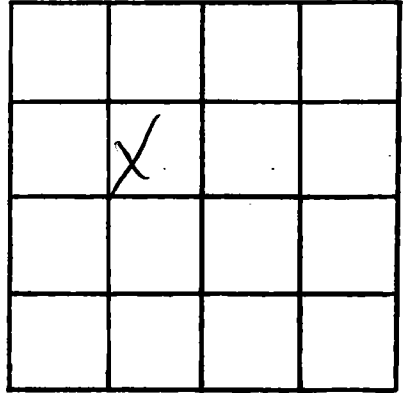

SECTION _____

Please indicate well location X.

ADDITIONAL INFORMATION

If more than one screen,
show locations of each on sketch.