

HARRISON  
 O  
 2154

MISSISSIPPI DEPARTMENT OF NATURAL RESOURCES  
 Bureau of Land and Water Resources  
 Southport Mall  
 P.O. Box 10631  
 Jackson, Mississippi 39209  
**WATER WELL DRILLERS LOG**

11-12 1985 McMill Pump & Well Harrison  
 date well completed firm name county well located

LANDOWNER: Mr. C. Luber  
Rt. 1 Box 676  
Long Beach, Mo. 64560  
 (mailing address)

description of formations encountered	from	to
<u>Mud</u>	<u>0</u>	<u>10</u>
<u>Sand</u>	<u>10</u>	<u>70</u>
<u>Mud</u>	<u>70</u>	<u>200</u>
<u>Sand</u>	<u>200</u>	<u>240</u>

WELL LOCATION:  
 sec. 8 T. 9 N. R. 12 E.  
1 miles N of Long Beach  
 (distance) (direction) (nearest town)

WELL PURPOSE:  
 (home, irrigation, municipal, industrial)

WELL COMPLETION DATA:

- (1) diameter (inches) 2"
- (2) total depth (feet) 240'
- (3) static water level (feet) 20' below above top of ground.
- (4) casing Sch 40 PVC 230'  
 (material) (depth)

(size) If telescope see back.

- (5) screen 10', 230'  
 (length) (depth to top)
- 2" Sch 80 PVC - 6 slot  
 (size) (material)

- (6) pump N/A  
 (type) (yield gpm)
- (type power)

- (7) electric log                       
 (yes or no)

(organization running log)


- (8) how well bottom plugged Sand  
Shale

DRILLERS REMARKS:

**RECEIVED**  
 NOV 26 1985

If well telescopes please sketch and show depths.

GROUND LEVEL

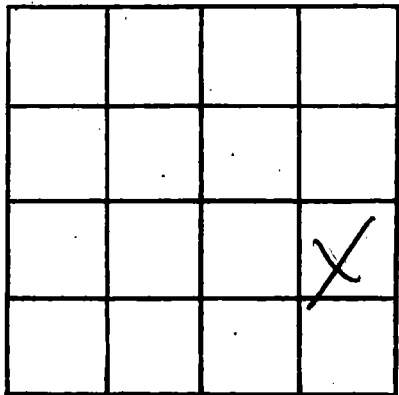

SECTION \_\_\_\_\_

Please indicate well location X.

ADDITIONAL INFORMATION

If more than one screen, show locations of each on sketch.