

MISSISSIPPI DEPARTMENT OF NATURAL RESOURCES

Bureau of Land and Water Resources

Southport Mall

P.O. Box 10631

Jackson, Mississippi 39209

WATER WELL DRILLERS LOG

Harrison
 2155

11-18-85 19 Mc Mee Pump & Wells Harrison
 date well completed firm name county well located

LANDOWNER: Roger Coast
 Submer Byrwood Dr.
 Gulfport, Mo.
 (mailing address)

WELL LOCATION:
 sec. 2 T. 85 N R. 12 W E
 2 miles South of Beaumont
 (distance) (direction) (nearest town)

WELL PURPOSE:
 (home, irrigation, municipal, industrial)

WELL COMPLETION DATA:
 (1) diameter (inches) 2"
 (2) total depth (feet) 600'
 (3) static water level (feet) 20' below top of ground
 (4) casing 4" sch 40, 590' (material) (depth)
 (size) If telescope see back.
 (5) screen 10' 590' (length) (depth to top)
 2" sch 50 6' dia (size) (material)
 (6) pump 1 (HP) 10 (yield gpm)
 elec. (type power)
 (7) electric log (yes or no)
 (organization running log)
 (8) how well bottom plugged Seal

description of formations encountered	from	to
Sand	0	20
Sand	20	40
Sand/mud	40	60
Sand	60	80
Sand	80	100
Sand/mud	100	120
mud	120	140
mud	140	160
mud	160	180
Mud	180	200
mud	200	220
mud	220	240
mud	240	260
mud	260	280
mud	280	300
mud	300	320
mud	320	340
mud	340	360
mud	360	380
mud	380	400
mud	400	420
mud	420	440
mud	440	460
mud	460	480
mud	480	500
grud/sand	500	520
Sand/mud	520	540
Sand/mud	540	560
Sand	560	580
Sand	580	600

RECEIVED


DEC 18 1985

DRILLERS REMARKS:

Department of Natural Resources
 Bureau of Land & Water Resources

If well telescopes please sketch and show depths.

GROUND LEVEL

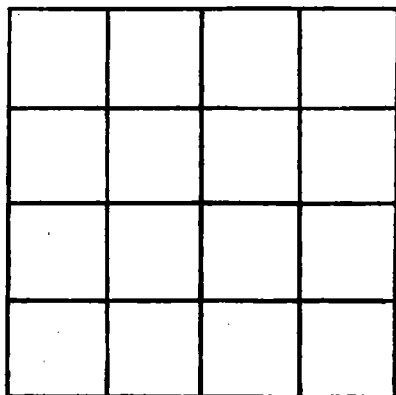

SECTION _____

Please indicate well location X.

ADDITIONAL INFORMATION

If more than one screen,
show locations of each on sketch.