

MISSISSIPPI DEPARTMENT OF NATURAL RESOURCES
Bureau of Land and Water Resources
 Southport Mall
 P.O. Box 10631
 Jackson, Mississippi 39209
WATER WELL DRILLERS LOG

HARRISON
Q 2156

10-24-85 19 Ry Moore Well Drilling HARRISON
 date well completed firm name county well located

LANDOWNER: B. J. Neyrey
RT 1 Box 437
2089 Beard MS
 (mailing address)

WELL LOCATION:
 sec. 12 T. 8 N. R. 12 E.
1 N Long Branch
 (distance) miles (direction) of (nearest town)

WELL PURPOSE:
 Home Irrigation Municipal Industrial

WELL COMPLETION DATA:

(1) diameter (inches) 2"

(2) total depth (feet) 600'

(3) static water level (feet) 25' ^{below}/_{above} top of ground.

(4) casing PVC 600'
 (material) (depth)
 (size) if telescope see back.

(5) screen 8'x10' 600
 (length) (depth to top)
 (size) PVC
 (material)

(6) pump 1 10
 (HP) (yield gpm)
E
 (type power)

(7) electric log
 (yes or no)
 (organization running log)

(8) how well bottom plugged By

description of formations encountered	from	to
TOP SOIL	0	15
White Silts &	15	45
White & Blue clay	45	120
FINE SILTY Silts	120	150
Blue clay	150	400
FINE Silts &	400	460
Blue clay	460	550
Coarse Sand	550	600


RECORDED
 JAN 6 1986

Department of Natural Resources
 Bureau of Land & Water Resources

DRILLERS REMARKS:

If well telescopes please sketch and show depths.

GROUND LEVEL

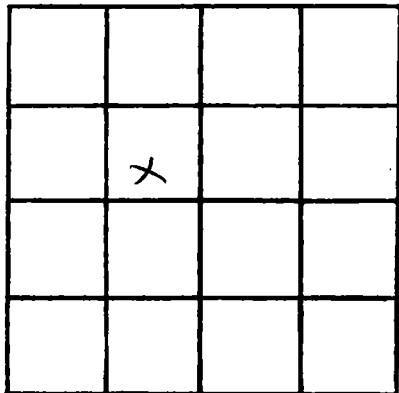

SECTION 12

Please indicate well location X.

ADDITIONAL INFORMATION

If more than one screen, show locations of each on sketch.