

MISSISSIPPI DEPARTMENT OF NATURAL RESOURCES
Bureau of Land and Water Resources
 Southport Mall
 P.O. Box 10631
 Jackson, Mississippi 39209
WATER WELL DRILLERS LOG

HARRISON
 Ⓞ
 2158

date well completed 19 9-21-85 firm name Korman county well located Harrison

LANDOWNER: Southwater Services
Southwater Co.
Pars Christian 3957
 (mailing address)

Description of formations encountered	from	to
	<u>red clay</u>	<u>0</u>
<u>blue clay</u>	<u>40</u>	<u>460</u>
<u>coarse sand</u>	<u>460</u>	<u>473</u>

WELL LOCATION:
 sec. 8-T-8 N R. 12 E
1/4 miles (distance) n miles (direction) of pass. (nearest town)

WELL PURPOSE: home
 (home, irrigation, municipal, industrial)

- WELL COMPLETION DATA:
- diameter (inches) 2"
 - total depth (feet) 473
 - static water level (feet) 221 below top of ground
 - casing P.V.C. (material), (depth) _____
 (size) if telescope see back.
 - screen 10 FT. plastic (length), (depth to top) _____
2 (size), plastic (material)
 - pump D.C. (HP), (yield gpm) _____
electric (type power)
 - electric log no (yes or no)
no (organization running log)
 - how well bottom plugged sand
shark


RECEIVED
 APR 2 1986

Department of Natural Resources
 Bureau of Land & Water Resources

DRILLERS REMARKS:

If well telescopes please sketch and show depths.

GROUND LEVEL

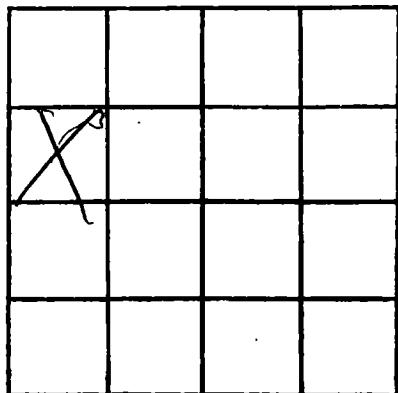

SECTION 8

Please indicate well location X.

ADDITIONAL INFORMATION

If more than one screen,
show locations of each on sketch.