

MISSISSIPPI DEPARTMENT OF NATURAL RESOURCES

Bureau of Land and Water Resources

Southport Mall

P.O. Box 10631

Jackson, Mississippi 39209

WATER WELL DRILLERS LOG

Harrison  
 ①  
2159

4-1-86 19 McGee pump & wells ~~Harrison~~ Harrison  
 date well completed firm name county well located

LANDOWNER Marion Langdon

description of formations encountered from to

Long Beach, Mo.  
 (mailing address)

mud	0	10
sand	10	50
mud	50	280
sand	280	290
mud	290	420
mud & sand	420	480
sand	480	560

WELL LOCATION:  
 sec. 2 T. 8 N R. 12 E  
 S W  
3 miles N.W. of L.B.  
 (distance) (direction) (nearest town)

WELL PURPOSE: Home  
 (home, irrigation, municipal, industrial)

WELL COMPLETION DATA:

- (1) diameter (inches) 2"
- (2) total depth (feet) 560'
- (3) static water level (feet) 40' <sup>below</sup> <sub>above</sub> top of ground.
- (4) casing sch 40 PVC 550'  
 (material) (depth)  
 (size) if telescope see back.
- (5) screen 10' 550'  
 (length) (depth to top)  
2" sch 80 to slot  
 (size) (material)
- (6) pump 1 10  
 (HP) (yield gpm)  
elec.  
 (type power)
- (7) electric log —  
 (yes or no)  
 (organization running log)
- (8) how well bottom plugged Seal

**RECEIVED**


APR 21 1986

Department of Natural Resources  
 Bureau of Land & Water Resources

DRILLERS REMARKS:

If well telescopes please sketch and show depths.

GROUND LEVEL

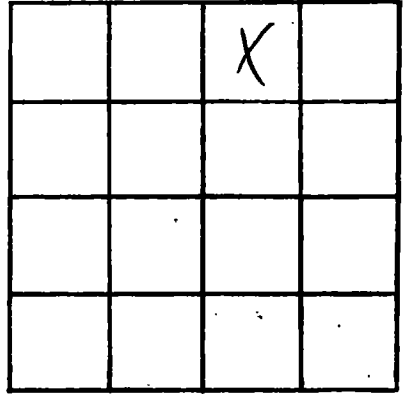

SECTION \_\_\_\_\_

Please indicate well location X.

ADDITIONAL INFORMATION

If more than one screen, show locations of each on sketch.