

MISSISSIPPI DEPARTMENT OF NATURAL RESOURCES

Bureau of Land and Water Resources

Southport Mall

P.O. Box 10631

Jackson, Mississippi 39209

WATER WELL DRILLERS LOG

Harrison
 ()
2160

1/29/86 19 Lyman Well Co. Harrison
 date well completed firm name county well located

LANDOWNER	Description of formations encountered	from	to
<u>William Smith</u>	<u>Topsoil</u>		<u>1'</u>
<u>P.O. Box 208</u>	<u>Sandy Clay</u>	<u>1'</u>	<u>83'</u>
<u>Pass Christian, MS</u> (mailing address)	<u>Sand</u>	<u>83'</u>	<u>146'</u>
	<u>Clay</u>	<u>146'</u>	<u>259'</u>
WELL LOCATION:	<u>Sand & Clay</u>	<u>259'</u>	<u>275'</u>
sec. <u>7</u> T. <u>8</u> N. R. <u>12</u> E.	<u>Clay</u>	<u>275'</u>	<u>422'</u>
<u>3</u> miles <u>N</u> of <u>PC.</u>	<u>Sand</u>	<u>422'</u>	<u>430'</u>
(distance) (direction) (nearest town)	<u>Clay</u>	<u>430'</u>	<u>518'</u>
WELL PURPOSE: <u>Home</u>	<u>Sand</u>	<u>518'</u>	<u>527'</u>
(home, irrigation, municipal, industrial)	<u>Clay</u>	<u>527'</u>	<u>606'</u>
WELL COMPLETION DATA:	<u>Sand</u>	<u>606'</u>	<u>628'</u>
(1) diameter (inches) <u>2"</u>			
(2) total depth (feet) <u>628'</u>			
(3) static water level (feet) <u>20'</u> <u>below</u> top of ground.			
(4) casing <u>PVC</u> <u>618'</u> (material) (depth)			
<u>2"</u> (size) if telescope see back.			
(5) screen <u>10'</u> <u>618'</u> (length) (depth to top)			
<u>2"</u> <u>PVC</u> (size) (material)			
(6) pump <u>1</u> <u>15</u> (HP) (yield gpm)			
<u>electric</u> (type power)			
(7) electric log <u>No</u> (yes or no)			
<u>NO</u> (organization running log)			
(8) how well bottom plugged <u>sand</u> <u>Shark</u>			
DRILLERS REMARKS:			


RECEIVED

OCT 14 1986

Department of Natural Resources
 Bureau of Land & Water Resources

If well telescopes please sketch and show depths.

GROUND LEVEL

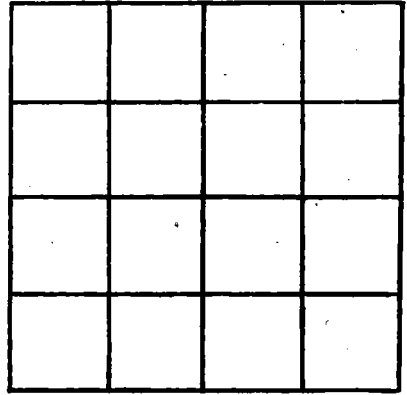

SECTION _____

Please indicate well location X.

ADDITIONAL INFORMATION

If more than one screen, show locations of each on sketch.