

MISSISSIPPI DEPARTMENT OF NATURAL RESOURCES

Bureau of Land and Water Resources

Southport Mall

P.O. Box 10631

Jackson, Mississippi 39209

WATER WELL DRILLERS LOG

Harrison
Φ 2162

7/29/86 19 Lyman Well Harrison
 date well completed firm name county well located

LANDOWNER: Frontier Homes
3866 Riverside
Now Point, Md 39563
 (mailing address)

WELL LOCATION:
 sec. 5 T. 8 N. R. 12 E.
 (distance) (direction) (nearest town)

WELL PURPOSE: Home
 (home, irrigation, municipal, industrial)

Description of formations encountered	from	to
Top soil		1'
Sandy, white clay	1'	16'
Sand	16'	24'
Sandy clay	24'	38'
Sand	38'	47'
Blue clay	47'	112'
Sand	112'	128'
Blue clay	128'	232'
Sand	232'	248'

WELL COMPLETION DATA:

(1) diameter (inches) 2"

(2) total depth (feet) 248'

(3) static water level (feet) 15' below top of ground

(4) casing PVC, 238'
 (material) (depth)

2" if telescope see back.
 (size)

(5) screen 10', 238'
 (length) (depth to top)

2", PVC
 (size) (material)

(6) pump 1 electric
 (HP) (yield gpm) (type power)

(7) electric log No
 (yes or no)
No
 (organization running log)

(8) how well bottom plugged sand
shark

RECEIVED


OCT 28 1986

Department of Natural Resources
 Bureau of Land & Water Resources

DRILLERS REMARKS:

If well telescopes please sketch and show depths.

GROUND LEVEL

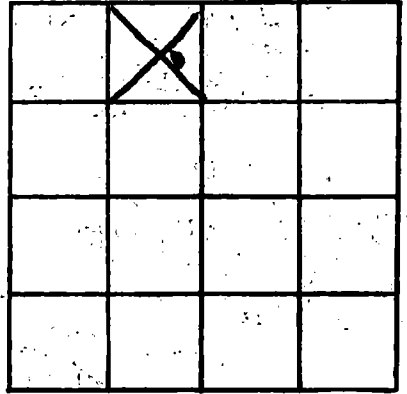

SECTION 5

Please indicate well location X:

ADDITIONAL INFORMATION

A series of horizontal lines for entering additional information.

DRIVER

If more than one screen, show locations of each on sketch.