

MISSISSIPPI DEPARTMENT OF NATURAL RESOURCES
Bureau of Land and Water Resources

P.O. Box 10631

Jackson, Mississippi 39209

WATER WELL DRILLERS LOG

COUNTY WELL LOCATED <i>Harrison</i>
WELL NUMBER CODED <i>Φ 2763</i>
DATE WELL COMPLETED <i>Sept. 21-86</i>

PERMIT NUMBER
NAME OF DRILLING FIRM <i>McMill Pump + Wells</i>

NAME & MAILING ADDRESS OF LANDOWNER <i>Mr. Paschner</i>			
WELL LOCATION: SEC <u>17</u> TOWNSHIP <u>8 N</u> RANGE <u>12 E</u>			
DISTANCE <u>2</u> Miles	DIRECTION <u>South</u>	NEAREST TOWN <u>Pensacola</u>	
OTHER LANDMARK			
WELL PURPOSE: Home, Irrigation, Municipal, Industrial, Fish Pond, etc. <i>Home</i>			

PUMP DATA		
PUMP TYPE (Circle One): Submersible, Turbine, <u>Jet</u> Flowing Well, Other (Describe) _____		
POWER TYPE (Circle One): <u>Electric</u> , Tractor, Diesel, Gasoline, Butane, Other (Describe) _____		
Pump Capacity (GPM) <u>12</u>	No. of Stages <u>2</u>	Setting Depth <u>40'</u> FT.
PUMP TEST		
Well yielded <u>12</u> GPM with a drawdown of <u>1</u> ft. after <u>1</u> hours of pumping		

WELL DATA		
Well Depth <u>620'</u>	Casing Diameter (In.) <u>2"</u>	Casing Length (Ft.) <u>610'</u>
Type of Casing <u>PVC</u>	Hole Depth <u>620'</u>	Depth to Static Water Level <u>20'</u>
TYPE OF COMPLETION: (Circle One or More): <u>Natural Development</u> , Underreamed, Telescoped, Open Hole, Other		
Top of Lap Pipe or Reduction in Casing		
FEET	IF TELESCOPED OR MORE THAN ONE SCREEN: USE BACK PAGE	

LOG DATA	
TYPE OF LOG RUN (Circle One): Electric, Gamma Ray, Density, Sonic, <u>No Log Run</u> , Other (Describe) _____	
Name of Organization Running Log	

SCREEN DATA		
Diameter - Inches <u>2"</u>	Length - Feet <u>10'</u>	Slot Size - Inches <u>6ths</u>
Screen Type <u>PVC</u>	Depth to Bottom - Feet <u>620'</u>	

GEOLOGIC DATA (Office Use Only)			
Surface Elev.	Geologic Unit	Unit Thickness	Depth to Top
Subs. SWL	Date	Analysis	Aquifer Test
Driller's Remarks			

DESCRIPTION OF FORMATIONS ENCOUNTERED	FROM	TO	FORMATION CONTINUED	
			FROM	TO
<i>Sand</i>	<i>0</i>	<i>60</i>	<i>60</i>	<i>570</i>
<i>Mud</i>	<i>60</i>	<i>80</i>	<i>570</i>	<i>620</i>
<i>Sand</i>	<i>80</i>	<i>140</i>		
<i>Mud</i>	<i>140</i>	<i>160</i>		
<i>Sand</i>	<i>160</i>	<i>180</i>		
<i>Mud</i>	<i>180</i>	<i>260</i>		
<i>Sand</i>	<i>260</i>	<i>290</i>		
<i>Mud</i>	<i>290</i>	<i>410</i>		
<i>Sand</i>	<i>410</i>	<i>460</i>		
<i>Sand</i>	<i>460</i>	<i>480</i>		

RECEIVED


NOV 3 1986

Department of Natural Resources
Bureau of Land & Water Resources

IF MORE SPACE IS NEEDED, USE BACK

If well telescopes please
sketch and show depths.

GROUND LEVEL

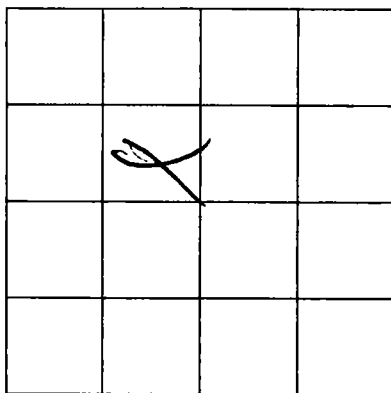

SECTION _____

Please indicate well location X.

ADDITIONAL INFORMATION

If more than one screen,
show location of each on sketch.