

Harrison  
 2164

MISSISSIPPI  
 BOARD OF WATER COMMISSIONERS  
 416 North State Street  
 Jackson, Mississippi 39201

WATER WELL DRILLERS LOG

10-6-86

R. J. Moore

STARKS014

date well completed

firm name

county well located

LANDOWNER: William H. SPARANCO  
 64 AD ACRES LOT #8

description of formations encountered

from

to

PASS CHRISTIAN MS  
 (mailing address)

TOP SOIL	0	10
WHITE SAND	10	60
Blue clay	60	280
Coarse sand	280	290
Blue clay	290	360
Fine sand	360	400
Blue clay	400	590
Coarse sand	590	620

WELL LOCATION:

sec. 8 T. 8 N. R. 12 E.  
 1 miles N of PASS CHRISTIAN  
 (distance) (direction) (nearest town)

WELL PURPOSE:

(home irrigation, municipal, industrial)

WELL COMPLETION DATA:

- (1) diameter (inches) 2"
- (2) total depth (feet) 620'
- (3) static water level (feet) 50' below top of ground
- (4) casing PUC 620' (material) (depth)
- (size) if telescope see back.
- (5) screen 10' 620' (length) (depth to top)
- 2" PUC (size) (material)
- (6) pump 1 8 (HP) (yield gpm)
- E (type power)
- (7) electric log (yes or no)
- (organization running log)
- (8) how well bottom plugged Better

RECEIVED


JAN 02 1987

Department of Natural Resources  
 Bureau of Land & Water Resources

DRILLERS REMARKS:

If well telescopes please sketch and show depths.

GROUND LEVEL

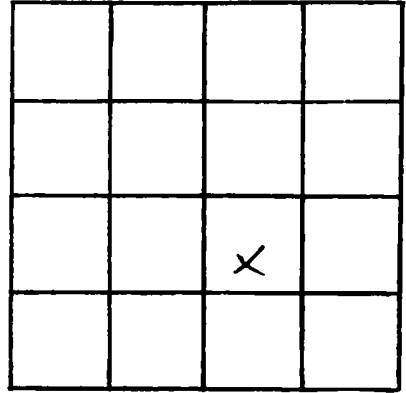

SECTION 8

Please indicate well location X.

ADDITIONAL INFORMATION

If more than one screen, show locations of each on sketch.