

**MISSISSIPPI  
BOARD OF WATER COMMISSIONERS**  
416 North State Street  
Jackson, Mississippi 39201

**WATER WELL DRILLERS LOG**

HARRISON  
Φ 2165

11-22-86 19  
date well completed

R. J. Moore  
firm name

HARRISON  
county well located

LANDOWNER: <u>MIKE JANKINS</u> <u>DARKICK RD</u>	description of formations encountered	from	to
<p><u>PASS, CHRISTIAN</u> (mailing address)</p>	<p><u>TOP SOIL COARSE SAND</u> <u>Blue Clay</u> <u>COARSE SAND</u></p>	<p><u>0</u> <u>40</u> <u>600</u></p>	<p><u>40</u> <u>600</u> <u>640</u></p>
<p><b>WELL LOCATION:</b> sec. <u>8</u> T. <u>8</u> N. R. <u>12</u> E <u>1</u> miles <u>N</u> of <u>PASS CHRISTIAN</u> (distance) (direction) (nearest town)</p>			
<p><b>WELL PURPOSE:</b> (home, irrigation, municipal, industrial)</p>			
<p><b>WELL COMPLETION DATA:</b></p>			
<p>(1) diameter (inches) <u>2"</u></p>			
<p>(2) total depth (feet) <u>640</u></p>			
<p>(3) static water level (feet) <u>18</u> <sup>below</sup> <sub>above</sub> top of ground.</p>			
<p>(4) casing <u>Pre</u> <u>640</u> (material) (depth) <u>        </u> If telescope see back. (size)</p>			
<p>(5) screen <u>10'</u> <u>640</u> (length) (depth to top) <u>2"</u> <u>Pre</u> (size) (material)</p>			
<p>(6) pump <u>1</u> <u>10</u> (HP) (yield gpm) <u>E</u> (type power)</p>			
<p>(7) electric log <u>        </u> (yes or no) <u>        </u> (organization running log)</p>			
<p>(8) how well bottom plugged <u>Pre</u></p>			
<p><b>DRILLERS REMARKS:</b></p>			


**RECEIVED**

JAN 02 1987

Department of Natural Resources  
Bureau of Land & Water Resources

If well telescopes please sketch and show depths.

GROUND LEVEL

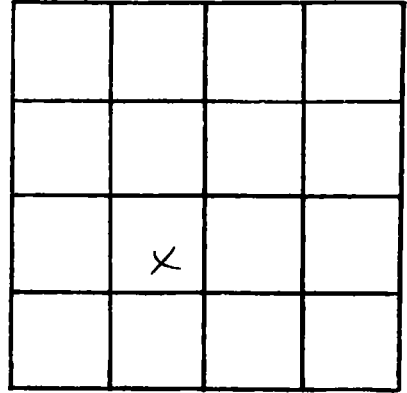

SECTION 8

Please indicate well location X.

ADDITIONAL INFORMATION

If more than one screen, show locations of each on sketch.