

Bureau of Land and Water Resources  
 Southport Mall  
 P.O. Box 10631  
 Jackson, Mississippi 39209  
**WATER WELL DRILLERS LOG**

Harrison  
Φ 2167

6/29/83 19 Braden Pump & Well Service Harrison  
 date well completed firm name county well located

LANDOWNER: Theodore Lawyer  
315 McDonald Dr.  
Pass Christian, Ms. 39571  
 (mailing address)

WELL LOCATION:  
30 sec T 8 & R 12 E  
~~sec~~ S W  
in miles Pass Christian  
 (distance) (direction) (nearest town)

WELL PURPOSE: Lawn sprinkler  
 (home, irrigation, municipal, industrial)

WELL COMPLETION DATA:

- (1) diameter (inches) 4 X 2
- (2) total depth (feet) 580 ft
- (3) static water level (feet) 1 below above top of ground
- (4) casing PVC 560  
 (material) (depth)  
4 X 2 if telescope see back.  
 (size)
- (5) screen 10 560  
 (length) (depth to top)  
2 PVC Underbars  
 (size) (material)
- (6) pump 1 HP sub 20  
 (HP) (yield gpm)  
220V 1Ø  
 (type power)
- (7) electric log NO  
 (yes or no)
- (organization running log)
- (8) how well bottom plugged PVC  
sand shock

description of formations encountered	from	to
sand	0	40
sand & gravel	40	60
sand	60	80
clay - blue	80	220
sand & clay	220	230
clay - blue	230	340
shale	340	345
sand & clay	345	360
clay blue	360	480
sand & clay	480	500
dry sand	500	580

**Braden Pump & Well Service, Inc.**  
 RECEIVED  
 Box 676  
 Sledge, MS 39554  
 FEB 25 1987

Department of Natural Resources  
 Bureau of Land & Water Resources

DRILLERS REMARKS: 10 ft  
Tachip


If well telescopes please sketch and show depths.

GROUND LEVEL

200' 4" PVC

360' 3" PVC

10' 2" PVC  
18' tail pipe

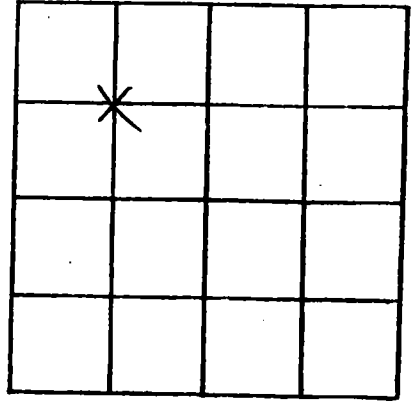

SECTION 30

Please indicate well location X.

ADDITIONAL INFORMATION

If more than one screen, show locations of each on sketch.