

MISSISSIPPI DEPARTMENT OF NATURAL RESOURCES
Bureau of Land and Water Resources

P.O. Box 10631
Jackson, Mississippi 39209
WATER WELL DRILLERS LOG

COUNTY WELL LOCATED HARRISON	
WELL NUMBER Φ 2169	CODED
DATE WELL COMPLETED MARCH 24-1987	

PERMIT NUMBER 0-239
NAME OF WELL PUMP & WELLS RT1 BOX 1643 CANAL RD GUPT, MS 39503

NAME & MAILING ADDRESS OF LANDOWNER John Bruce 302 Serrick Rd Pass Cr. Ms.			
WELL LOCATION:	SEC 17	TOWNSHIP 3	RANGE N 12 E
DISTANCE 3	DIRECTION South	NEAREST TOWN Pinewville	
OTHER LANDMARK			
WELL PURPOSE <input checked="" type="checkbox"/> Home Irrigation, Municipal, Industrial, Fish Pond, etc.			

PUMP DATA		
PUMP TYPE (Circle One): <input checked="" type="checkbox"/> Submersible, <input type="checkbox"/> Turbine, <input checked="" type="checkbox"/> Flowing Well, Other (Describe) _____		
POWER TYPE (Circle One): <input checked="" type="checkbox"/> Electric, <input type="checkbox"/> Tractor, <input type="checkbox"/> Diesel, <input type="checkbox"/> Gasoline, <input type="checkbox"/> Butane, Other (Describe) _____		
Pump Capacity (GPM) 18-25	No. of Stages 14	Setting Depth 80' FT.
PUMP TEST		
Well yielded 20 GPM with a drawdown of 10 ft. after 1 hours of pumping		

WELL DATA		
Well Depth 600'	Casing Diameter (In.) 4" X 2"	Casing Length (Ft.) 20
Type of Casing PVC	Hole Depth 600'	Depth to Static Water Level 20'
TYPE OF COMPLETION: (Circle One or More): <input checked="" type="checkbox"/> Gravel Packed, <input type="checkbox"/> Underreamed, <input type="checkbox"/> Telescoped, <input checked="" type="checkbox"/> Natural Development, <input type="checkbox"/> Open Hole, <input type="checkbox"/> Other (Describe) _____		
Top of Lap Pipe or Reduction in Casing		
FEET	IF TELESCOPED OR MORE THAN ONE SCREEN: USE BACK PAGE	

LOG DATA	
TYPE OF LOG RUN (Circle One): <input checked="" type="checkbox"/> No Log Run Electric, Gamma Ray, Density, Sonic, Neutron, Other (Describe) _____	
Name of Organization Running Log	

SCREEN DATA		
Diameter - Inches 2"	Length - Feet 20'	Slot Size - Inches .0006
Screen Type 10ch80 pvc	Depth to Bottom - Feet 580'	


GEOLOGIC DATA (Office Use Only)			
Surface Elev.	Geologic Unit	Unit Thickness	Depth to Top
Subs. SWL	Date	Analysis	Aquifer Test
Driller's Remarks			

DESCRIPTION OF FORMATIONS ENCOUNTERED	FROM	TO	FORMATIONS (Continued)	FROM	TO
Sand	0	120	RECEIVED MAY 27 1987 Department of Natural Resources Bureau of Land & Water Resources		
Mud	120	240			
Sand	260	280			
Mud	280	290			
Sand	290	310			
Mud	310	540			
Sand	540	600			

IF MORE SPACE IS NEEDED, USE BACK

If well telescopes please sketch and show depths.

GROUND LEVEL

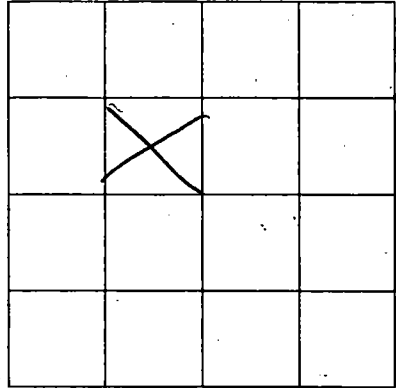

SECTION _____

Please indicate well location X.

ADDITIONAL INFORMATION

If more than one screen,
show location of each on sketch.