

MISSISSIPPI DEPARTMENT OF NATURAL RESOURCES

Bureau of Land and Water Resources

Southport Mall

P.O. Box 10631

Jackson, Mississippi 39209

WATER WELL DRILLERS LOG

Harrison
 # 2176

9-18-87 19
 date well completed

R. J. Woods
 firm name

HARRISON
 county well located

LANDOWNER: ~~State~~
MELVIN PAPIZION
EPsey Ave
PASS CHRISTIAN
 (mailing address)

description of formations encountered	from	to
TOP SOIL + Clay	0	20
Red Sand & Gravel	20	60
Blue Clay	60	460
med Sand	460	470
Coarse Sand	470	460

WELL LOCATION:
 sec. 9 T 8 N R. 12 E
1/2 miles SW of Pineville School
 (distance) (direction) (nearest town)

WELL PURPOSE:
 (Home) Irrigation, municipal, industrial

WELL COMPLETION DATA:

(1) diameter (inches) 2"

(2) total depth (feet) 460'

(3) static water level (feet) 30' below above top of ground.

(4) casing Pvc, 460,
 (material) (depth)
 (size) If telescope see back.

(5) screen 10', 460
 (length) (depth to top)
2", Pvc
 (size) (material)

(6) pump 1 6
 (HP) (yield gpm)
E
 (type power)

(7) electric log
 (yes or no)

 (organization running log)

(8) how well bottom plugged
Burnt

DRILLERS REMARKS:


RECEIVED

NOV 04 1987

Department of Natural Resources
 Bureau of Land & Water Resources

If well telescopes please sketch and show depths.

GROUND LEVEL

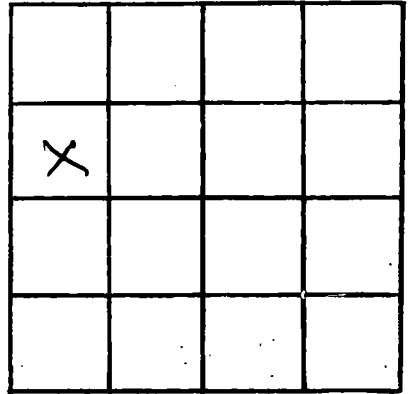

SECTION 2

Please indicate well location X.

ADDITIONAL INFORMATION

If more than one screen,
show locations of each on sketch.