

**MISSISSIPPI DEPARTMENT OF NATURAL RESOURCES**  
**Bureau of Land and Water Resources**  
 Southport Mall  
 P.O. Box 10631  
 Jackson, Mississippi 39209  
**WATER WELL DRILLERS LOG**

HARRISON  
Q 2177

7-19-87 19  
 date well completed

R. V. Moore  
 firm name

HARRISON  
 county well located

LANDOWNER: R. M. LASSAB  
Leddie Frank RO  
PASS CHRISTIAN MS  
 (mailing address)

description of formations encountered	from	to
Top Soil	0	20
Red Sand	20	70
Blue Clay	70	350
Red Sand	350	390

WELL LOCATION:  
 sec. 3 T. 8 N. R. 12 E.  
2 miles N of Pineville School  
 (distance) (direction) (nearest town)

WELL PURPOSE:  
 (Irrigation, municipal, Industrial)

- WELL COMPLETION DATA:
- (1) diameter (inches) 2"
  - (2) total depth (feet) 390'
  - (3) static water level (feet) 50' <sup>below</sup> <sub>above</sub> top of ground.
  - (4) casing Pvc, 390'  
 (material) (depth)  
 (size) If telescope see back.
  - (5) screen 10', 390  
 (length) (depth to top)  
2", Pvc  
 (size) (material)
  - (6) pump 1, 6  
 (HP) (yield gpm)  
E  
 (type power)
  - (7) electric log (yes or no) \_\_\_\_\_  
 (organization running log) \_\_\_\_\_
  - (8) how well bottom plugged Partial

DRILLERS REMARKS: \_\_\_\_\_


**RECEIVED**

NOV 04 1987

Department of Natural Resources  
 Bureau of Land & Water Resources

If well telescopes please sketch and show depths.

GROUND LEVEL

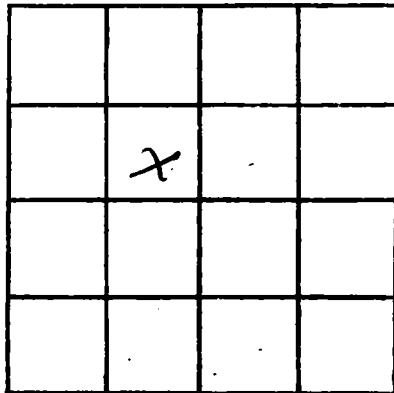

SECTION 3

Please indicate well location X.

ADDITIONAL INFORMATION

If more than one screen,  
show locations of each on sketch.