

MISSISSIPPI DEPARTMENT OF NATURAL RESOURCES
Bureau of Land and Water Resources
 Southport Mall
 P.O. Box 10631
 Jackson, Mississippi 39209
WATER WELL DRILLERS LOG

Harrison
2178

8-9-87 19 87 R. J. Mecke HARRISON
 date well completed firm name county well located

LANDOWNER:
George M Wilson
EP Sey Ave
PASS CHRISTIAN MS
 (mailing address)

description of formations encountered	from	to
<u>TOP SdL + clay</u>	<u>0</u>	<u>20</u>
<u>Blue S + sh</u>	<u>20</u>	<u>60</u>
<u>Blue clay</u>	<u>60</u>	<u>400</u>
<u>med S + sh</u>	<u>400</u>	<u>420</u>
<u>Coarse S + sh</u>	<u>420</u>	<u>440</u>

WELL LOCATION:
 sec. 4 T. 8 N. R. 12 E.
1 1/4 miles E of Pineville
 (distance) (direction) (nearest town)

WELL PURPOSE:
 home irrigation, municipal, industrial

WELL COMPLETION DATA:

(1) diameter (inches) 2"

(2) total depth (feet) 440'

(3) static water level (feet) 30' below above top of ground.

(4) casing pc 440'
 (material) (depth)
 (size) if telescope see back.

(5) screen 10' 440'
 (length) (depth to top)
2" pc
 (size) (material)

(6) pump 1/2 6
 (HP) (yield gpm)
F
 (type power)

(7) electric log —
 (yes or no)
 (organization running log)

(8) how well bottom plugged fair

DRILLERS REMARKS:
1


RECEIVED

NOV 04 1987

Department of Natural Resources
 Bureau of Land & Water Resources

If well telescopes please sketch and show depths.

GROUND LEVEL

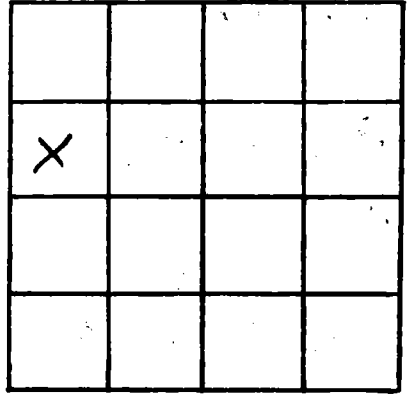

SECTION 4

Please indicate well location X.

ADDITIONAL INFORMATION

If more than one screen, show locations of each on sketch.