

MISSISSIPPI DEPARTMENT OF NATURAL RESOURCES

Bureau of Land and Water Resources

P.O. Box 10631

Jackson, Mississippi 39209

WATER WELL DRILLERS LOG

COUNTY WELL LOCATED  
**N Harrison**

WELL NUMBER  
**2179**

CODED

DATE WELL COMPLETED  
**8-19-81**

PERMIT NUMBER  
**0249**

NAME OF DRILLING FIRM  
**RT1 BOX 1643 CANAL RD  
GUPT, MS 39503**

NAME & MAILING ADDRESS OF LANDOWNER  
**RL. Sauls  
120 Vada Dr.  
Pass Cr. Ms.**

WELL LOCATION: SEC **17** TOWNSHIP **8 N** RANGE **12 E**

DISTANCE \_\_\_\_\_ DIRECTION \_\_\_\_\_ NEAREST TOWN \_\_\_\_\_  
Miles \_\_\_\_\_ of \_\_\_\_\_

OTHER LANDMARK \_\_\_\_\_

WELL PURPOSE: Home, Irrigation, Municipal, Industrial, Fish Pond, etc.  
**home**

PUMP DATA

PUMP TYPE (Circle One):  
Submersible, Turbine, **Jet** Flowing Well,  
Other (Describe) \_\_\_\_\_

POWER TYPE (Circle One):  
**Electric** Tractor, Diesel, Gasoline, Butane,  
Other (Describe) \_\_\_\_\_

Pump Capacity (GPM) **8-10** No. of Stages **2** Setting Depth **20'** FT.

PUMP TEST

Well yielded **12** GPM with  
a drawdown of **5** ft.  
after **1** hours of pumping

WELL DATA

Well Depth <b>170</b>	Casing Diameter (In.) <b>2"</b>	Casing Length (Ft.) <b>20</b>
Type of Casing <b>PVC</b>	Hole Depth <b>70</b>	Depth to Static Water Level <b>3'</b>

TYPE OF COMPLETION: (Circle One or More):  
Gravel Packed, Underreamed, Telescoped,  
Natural Development, **Open Hole**, Other \_\_\_\_\_  
(Describe) \_\_\_\_\_

Top of Lap Pipe or Reduction in Casing  
FEET \_\_\_\_\_ IF TELESCOPED OR MORE THAN ONE SCREEN: USE BACK PAGE

LOG DATA

TYPE OF LOG RUN (Circle One): **No Log Run**  
Electric, Gamma Ray, Density, Sonic, Neutron,  
Other (Describe) \_\_\_\_\_

Name of Organization Running Log \_\_\_\_\_

SCREEN DATA

Diameter - Inches <b>2"</b>	Length - Feet <b>10'</b>	Slot Size - Inches <b>.0006</b>
Screen Type <b>2" x 10 PVC</b>	Depth to Bottom - Feet _____	

GEOLOGIC DATA (Office Use Only)

Surface Elev.	Geologic Unit	Unit Thickness	Depth to Top
Subs. SWL	Date	Analysis	Aquifer Test

Driller's Remarks

DESCRIPTION OF FORMATIONS ENCOUNTERED	FROM	TO
<b>Mud</b>	<b>0</b>	<b>10</b>
<b>Sand</b>	<b>10</b>	<b>70</b>

FORMATIONS ENCOUNTERED FROM TO

**RECEIVED**


**OCT 14 1981**

Department of Natural Resources  
Bureau of Land & Water Resources

IF MORE SPACE IS NEEDED, USE BACK

If well telescopes please sketch and show depths.

GROUND LEVEL

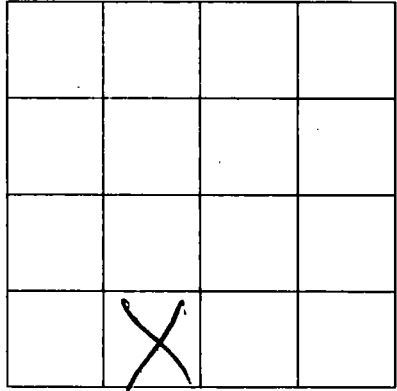

SECTION \_\_\_\_\_

Please indicate well location X.

ADDITIONAL INFORMATION

If more than one screen, show location of each on sketch.