

MISSISSIPPI DEPARTMENT OF NATURAL RESOURCES
Bureau of Land and Water Resources

P.O. Box 10631

Jackson, Mississippi 39209

WATER WELL DRILLERS LOG

COUNTY WELL LOCATED <i>Johnson</i>		PERMIT NUMBER <i>0239</i>
WELL NUMBER <i>2184</i>	CODED	NAME OF DRILLING FIRM <i>McMill Kump & Wolf</i>
DATE WELL COMPLETED <i>9-21-87</i>		<i>1643 Canal rd. apt.</i>

NAME & MAILING ADDRESS OF LANDOWNER
Charles Winer
7345 Basinger rd
apt

WELL LOCATION: SEC *5* TOWNSHIP *8 N* RANGE *12 E*

DISTANCE *5* Miles *SW* of *apt*

OTHER LANDMARK

WELL PURPOSE: Home Irrigation, Municipal, Industrial, Fish Pond, etc.

PUMP DATA

PUMP TYPE (Circle One):
Submersible, Turbine, Jet, Flowing Well,
Other (Describe) _____

POWER TYPE (Circle One):
 Electric, Tractor, Diesel, Gasoline, Butane,
Other (Describe) _____

Pump Capacity (GPM) <i>12</i>	No. of Stages <i>2</i>	Setting Depth <i>60'</i>	FT.
----------------------------------	---------------------------	-----------------------------	-----

PUMP TEST

Well yielded *12* GPM with
a drawdown of *8* ft.
after *1* hours of pumping

WELL DATA

Well Depth <i>515</i>	Casing Diameter (In.) <i>2"</i>	Casing Length (Ft.) <i>505</i>
Type of Casing <i>PVC</i>	Hole Depth <i>515</i>	Depth to Static Water Level <i>23'</i>

TYPE OF COMPLETION: (Circle One or More):
 Gravel Packed, Underreamed, Telescoped,
 Natural Development, Open Hole, Other
(Describe) _____

Top of Lap Pipe or Reduction in Casing
FEET IF TELESCOPED OR MORE THAN ONE SCREEN: USE BACK PAGE

LOG DATA

TYPE OF LOG RUN (Circle One):
Electric, Gamma Ray, Density, Sonic, No Log Run, Neutron,
Other (Describe) _____

Name of Organization Running Log

SCREEN DATA

Diameter - Inches <i>2"</i>	Length - Feet <i>10'</i>	Slot Size - Inches <i>.0006</i>
Screen Type <i>PVC</i>	Depth to Bottom - Feet <i>515</i>	

GEOLOGIC DATA (Office Use Only)

Surface Elev.	Geologic Unit	Unit Thickness	Depth to Top
Subs. SWL	Date	Analysis	Aquifer Test

Driller's Remarks

DESCRIPTION OF FORMATIONS ENCOUNTERED	FROM	TO	FORMATIONS (Continued)	FROM	TO
<i>Sand/Gravel</i>	<i>0</i>	<i>50</i>			
<i>Mud</i>	<i>50</i>	<i>200</i>			
<i>Shreaky mud/sand</i>	<i>200</i>	<i>250</i>			
<i>Mud</i>	<i>250</i>	<i>380</i>			
<i>Sand</i>	<i>380</i>	<i>400</i>			
<i>Mud</i>	<i>400</i>	<i>480</i>			
<i>Sand</i>	<i>480</i>	<i>515</i>			

RECEIVED


OCT 14 1987

Department of Natural Resources
Bureau of Land & Water Resources

IF MORE SPACE IS NEEDED, USE BACK

If well telescopes please sketch and show depths.

GROUND LEVEL

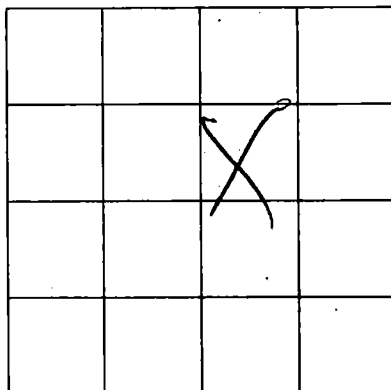

SECTION _____

Please indicate well location X.

ADDITIONAL INFORMATION

If more than one screen,
show location of each on sketch.