

MISSISSIPPI DEPARTMENT OF NATURAL RESOURCES

Bureau of Land and Water Resources

Southport Mall

P.O. Box 10631

Jackson, Mississippi 39209

WATER WELL DRILLERS LOG

Harrison  
 2190  
 0239

November 30, 1987 McNeil Pump Wells Harrison  
 date well completed firm name county well located

LANDOWNER: Tom Oliver  
7121 Leggette rd.  
Pang Beach Ms.  
 (mailing address)

description of formations encountered	from	to
	<u>Mud</u>	<u>0</u>
<u>hard</u>	<u>10</u>	<u>20</u>
<u>mud</u>	<u>20</u>	<u>190</u>
<u>Sand</u>	<u>190</u>	<u>240</u>

WELL LOCATION:  
 sec. 5 T. 8 N. R. 12 E.  
5 miles WEST of 4pt.  
 (distance) (direction) (nearest town)

WELL PURPOSE:  
 (home) Irrigation, municipal, industrial

- WELL COMPLETION DATA:
- (1) diameter (inches) 2"
  - (2) total depth (feet) 240
  - (3) static water level (feet) 15' <sup>below</sup> <sub>above</sub> top of ground
  - (4) casing PVC, 230'  
 (material) (depth)  
2"  
 (size) If telescope see back.
  - (5) screen 10', 240'  
 (length) (depth to top)  
2", PVC  
 (size) (material)
  - (6) pump 1, 13  
 (HP) (yield gpm)  
electric  
 (type power)
  - (7) electric log (yes or no)  
 (organization running log)
  - (8) how well bottom plugged Seal

RECEIVED


JAN 27 1988

Department of Natural Resources  
 Bureau of Land & Water Resources

DRILLERS REMARKS:

If well telescopes please sketch and show depths.

GROUND LEVEL

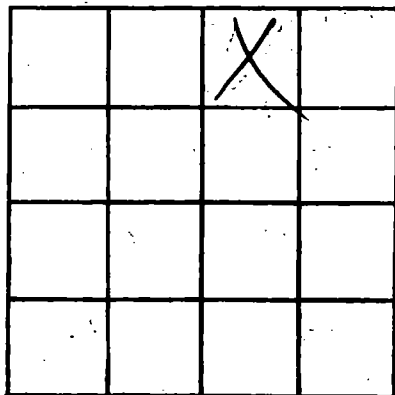

SECTION \_\_\_\_\_

Please indicate well location X.

ADDITIONAL INFORMATION

RECEIVED

U.S. GEOLOGICAL SURVEY  
WASHINGTON, D.C. 20508

If more than one screen, show locations of each on sketch.