

Bureau of Land and Water Resources

WATER WELL DRILLERS LOG

COUNTRY WELL LOCATED	
Darrusson	
WELL NUMBER	CODED
Φ 2192	
DATE WELL COMPLETED	
12/9/87	

PERMIT NUMBER	0239
NAME OF DRILLING FIRM	McNeil Pump & Wells

NAME & MAILING ADDRESS OF LANDOWNER

James Ward
3510 Olga de
Rosa Christiana Ms.

WELL LOCATION: SEC TOWNSHIP RANGE

18 8 S 12 W

DISTANCE DIRECTION NEAREST TOWN

2 Miles North of Rosa C.

OTHER LANDMARK

WELL PURPOSE: Homa Irrigation, Municipal, Industrial, Fish Pond, etc.

PUMP TYPE (Circle One):
Submersible, Turbine, Jet Flowing Well,
Other (Describe)

POWER TYPE (Circle One):
 Electric, Tractor, Diesel, Gasoline, Butane,
 Other (Describe)

Pump Capacity (GPM)	No. of Stages	Setting Depth
15	2	40' FT.

PUMP TEST

Well yielded 15 GPM with
a drawdown of 10 ft.
after 1 hours of pumping

WELL DATA

Well Depth 660'	Casing Diameter (In.) 2"	Casing Length (Ft.) 660'
Type of Casing PVC	Hole Depth 660'	Depth to Static Water Level 2'

TYPE OF COMPLETION: (Circle One or More):

Gravel Packed, Underreamed, Telescoped,
Natural Development, Open Hole, Other

(Describe) _____

Top of Lap Pipe or Reduction in Casing _____

FEET

IF TELESCOPED OR MORE THAN ONE SCREEN: USE BACK PAGE

LOG DATA

TYPE OF LOG RUN (Circle One): No Log Run
Electric, Gamma Ray, Density, Sonic, Neutron,
Other (Describe)

Name of Organization Running Log

GEOLOGIC DATA (Office Use Only)

Surface Elev.	Geologic Unit	Unit Thickness	Depth to Top
Subs. SWL	Date	Analysis	Aquifer Test


SCREEN DATA

Diameter - Inches 2"	Length - Feet 10'	Slot Size - Inches .0006
Screen Type PVC		Depth to Bottom - Feet 660'

Driller's Remarks[illegible]

If well telescopes please
sketch and show depths.

GROUND LEVEL

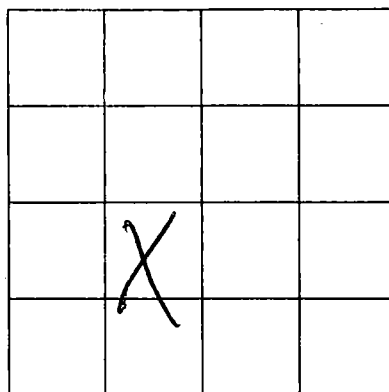

SECTION _____

Please indicate well location X.

ADDITIONAL INFORMATION

If more than one screen,
show location of each on sketch.