

MISSISSIPPI DEPARTMENT OF NATURAL RESOURCES

Bureau of Land and Water Resources

Southport Mall

P.O. Box 10631

Jackson, Mississippi 39209

WATER WELL DRILLERS LOG

Harrison
 # 2196
0239

Dec 18
 date well completed

1987 McNeil Pump & Well
 firm name

Harrison
 county well located

LANDOWNER: Mirkin Smith
3469 Olga Dr
Ros Christian
 (mailing address)

WELL LOCATION:
 sec 18 T 8 N R 12 E
2 miles South of Pineville
 (distance) (direction) (nearest town)

WELL PURPOSE:
 home irrigation, municipal, industrial

- WELL COMPLETION DATA:
- (1) diameter (inches) 2"
 - (2) total depth (feet) 1060'
 - (3) static water level (feet) 1' below above top of ground.
 - (4) casing Pvc, 1050',
 (material) (depth)
2"
 (size) if telescope see back.
 - (5) screen 10', 1060'
 (length) (depth to top)
2", Pvc
 (size) (material)
 - (6) pump 1 13
 (HP) (yield gpm)
Electric
 (type)
 - log yes (yes or no)
 - minimization running log
 - (8) how well bottom plugged Seal

description of formations encountered	from	to
	Sand	0
mud	70	110
sand	110	130
mud	130	195
sand	195	200
mud	200	300
sand	300	315
mud	315	380
sand	380	390
mud	390	590
sand	590	1060

RECEIVED


JAN 27 1988

Department of Natural Resources
 Bureau of Land & Water Resources

DRILLERS REMARKS:

If well telescopes please sketch and show depths.

GROUND LEVEL

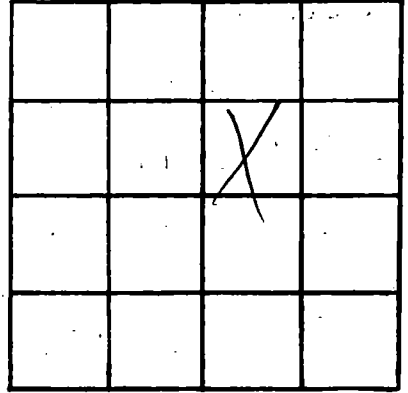

SECTION _____

Please indicate well location X.

ADDITIONAL INFORMATION

03/11/2019

If more than one screen, show locations of each on sketch.