

MISSISSIPPI DEPARTMENT OF NATURAL RESOURCES
Bureau of Land and Water Resources
 Southport Mall
 P.O. Box 10631
 Jackson, Mississippi 39209
WATER WELL DRILLERS LOG

Harrison
0239
Φ 2199

December 3 1987 McHill Pumpwell Harrison
 date well completed firm name county well located

LANDOWNER: Paul Millice
#3484 Olga dr.
Pass Christian Ms.
 (mailing address)

WELL LOCATION:
 sec. 18 T. 8 N. R. 12 E.
2 miles South of Pineville
 (distance) (direction) (nearest town)

WELL PURPOSE:
 (home) irrigation, municipal, industrial

- WELL COMPLETION DATA:
- (1) diameter (inches) 2"
 - (2) total depth (feet) 640'
 - (3) static water level (feet) 1 Below top of ground. Above
 - (4) casing PVC, 630',
 (material) (depth)
2"
 (size) If telescope see back.
 - (5) screen 10', 640'
 (length) (depth to top)
2", PVC
 (size) (material)
 - (6) pump 1, 13
 (HP) (yield gpm)
electric
 (type power)
 - (7) electric log no
 (yes or no)
 (organization running log)
 - (8) how well bottom plugged Seal

description of formations encountered	from	to
<u>Sand</u>	<u>0</u>	<u>60</u>
<u>Mud</u>	<u>60</u>	<u>220</u>
<u>Sand</u>	<u>220</u>	<u>230</u>
<u>Mud</u>	<u>230</u>	<u>570</u>
<u>Sand</u>	<u>570</u>	<u>640</u>

RECEIVED


JAN 27 1988

Department of Natural Resources
 Bureau of Land & Water Resources

DRILLERS REMARKS:

If well telescopes please sketch and show depths.

GROUND LEVEL

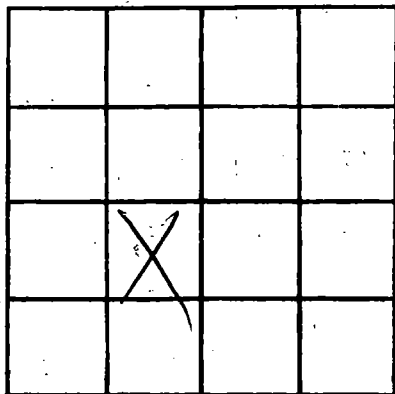

SECTION _____

Please indicate well location X.

ADDITIONAL INFORMATION

UNIVERSITY OF CALIFORNIA

1931 1 3 12

UNIVERSITY OF CALIFORNIA
DEPARTMENT OF GEOLOGY

If more than one screen,
show locations of each on sketch.