

MISSISSIPPI DEPARTMENT OF NATURAL RESOURCES

Bureau of Land and Water Resources

Southport Mall

P.O. Box 10631

Jackson, Mississippi 39209

WATER WELL DRILLERS LOG

Harrison
 \$ 2200
 0239

January 8, 1988 McHill Pumpwell Harrison
 date well completed firm name county well located

LANDOWNER: Verson Guilfoyle
3529 Fox Ave.
Law Christian, Ms
 (mailing address)

WELL LOCATION:
 sec. 18 T. 8 N. R. 12 E.
2 miles South of Lincolnton
 (distance) (direction) (nearest town)

WELL PURPOSE:
Home, Irrigation, municipal, Industrial

WELL COMPLETION DATA:

(1) diameter (inches) 2"
 (2) total depth (feet) 620'
 (3) static water level (feet) 1 below above top of ground.
 (4) casing PVC, 610'
 (material) (depth)
2" If telescope see back.
 (size)
 (5) screen 10', 620'
 (length) (depth to top)
2", PVC
 (size) (material)
 (6) pump 1 13
 (HP) (yield gpm)
electric
 power)
 (7) electric log no
 (yes or no)
 (organization running log)
 (8) how well bottom plugged Seal

description of formations encountered	from	to
Mud	0	10
Sand	10	80
Mud	80	280
Sand	280	300
Mud	300	560
Sand	560	620

RECEIVED


JAN 27 1988

Department of Natural Resources
 Bureau of Land & Water Resources

DRILLERS REMARKS:

If well telescopes please sketch and show depths.

GROUND LEVEL

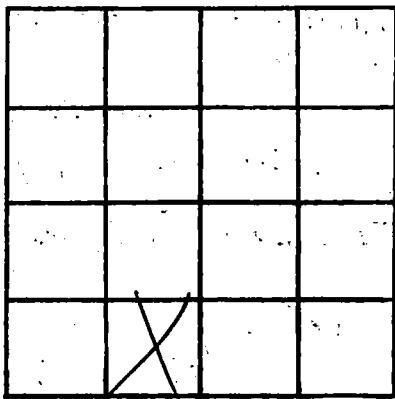

SECTION: _____

Please indicate well location X.

ADDITIONAL INFORMATION

RECEIVED

Department of Natural Resources
Division of Land & Water Resources

If more than one screen,
show locations of each on sketch.