

MISSISSIPPI DEPARTMENT OF NATURAL RESOURCES

Bureau of Land and Water Resources

Southport Mall

P.O. Box 10631

Jackson, Mississippi 39209

WATER WELL DRILLERS LOG

Harrison
 ⊕
 2202

4-18-88¹⁹
 date well completed

R.J. Moore
 firm name

HARRISON
 county well located

LANDOWNER: John Ashere
DAUGHERTY RD
PASS CHRISTIAN MS
 (mailing address)

description of formations encountered	from	to
TOP SoL	0	10
River Sand	10	30
White Clay	30	90
Coarse Sand	90	95
Blue Clay	95	200
Thin Sand	200	240
Blue Clay	240	460
Med Sand	460	500

WELL LOCATION:
 sec. 4 T. 8 N. R. 12 E
4 miles N of PASS CHRISTIAN
 (distance) (direction) (nearest town)

WELL PURPOSE:
 (home) irrigation, municipal, industrial

- WELL COMPLETION DATA:
- (1) diameter (inches) 2"
 - (2) total depth (feet) 500'
 - (3) static water level (feet) 18' ^{below} _{above} top of ground.
 - (4) casing PVC, 500'
 (material) (depth)
 (size) if telescope see back.
 - (5) screen 10', 500'
 (length) (depth to top)
2", PVC
 (size) (material)
 - (6) pump 1, 8
 (HP) (yield gpm)
E
 (type power)
 - (7) electric log
 (yes or no)

 (organization running log)
 - (8) how well bottom plugged BW White

RECEIVED


MAY 03 1988

Department of Natural Resources
 Bureau of Land & Water Resources

DRILLERS REMARKS:

If well telescopes please sketch and show depths.

GROUND LEVEL

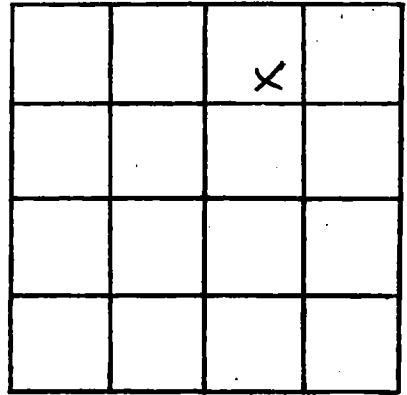

SECTION 4

Please indicate well location X.

ADDITIONAL INFORMATION

If more than one screen,
show locations of each on sketch.