

# MISSISSIPPI DEPARTMENT OF NATURAL RESOURCES

Bureau of Land and Water Resources

P.O. Box 10631

Jackson, Mississippi 39209

## WATER WELL DRILLERS LOG

COUNTY WELL LOCATED <b>HARRISON</b>	
WELL NUMBER <b>2203</b>	CODED
DATE WELL COMPLETED <b>MAY-2, 1988</b>	

PERMIT NUMBER <b>0239</b>
NAME OF DRILLING FIRM <b>McCall Pump &amp; Wells</b>

NAME & MAILING ADDRESS OF LANDOWNER <b>John Steube</b> <b>4185 W. Whittman Rd</b> <b>Pass Christian Ms.</b>		
WELL LOCATION: SEC	TOWNSHIP	RANGE
<b>10</b>	<b>8 N</b>	<b>12 E</b>
DISTANCE <b>4</b> Miles	DIRECTION <b>South</b> of	NEAREST TOWN <b>Delisle</b>
OTHER LANDMARK		
WELL PURPOSE <input checked="" type="radio"/> Home Irrigation, Municipal, Industrial, Fish Pond, etc.		

<b>PUMP DATA</b>		
PUMP TYPE (Circle One): Submersible, Turbine, <input checked="" type="radio"/> Jet, Flowing Well, Other (Describe) _____		
POWER TYPE (Circle One): Electric, Tractor, Diesel, Gasoline, Butane, Other (Describe) _____		
Pump Capacity (GPM) <b>13</b>	No. of Stages <b>2</b>	Setting Depth <b>20'</b> FT.
PUMP TEST		
Well yielded <b>13</b> GPM with a drawdown of <b>10</b> ft. after <b>1</b> hours of pumping		

<b>WELL DATA</b>		
Well Depth <b>300'</b>	Casing Diameter (In.) <b>2"</b>	Casing Length (Ft.) <b>280'</b>
Type of Casing <b>PVC</b>	Hole Depth <b>300'</b>	Depth to Static Water Level <b>12" ABOVE Ground Level</b>
TYPE OF COMPLETION: (Circle One or More): <input checked="" type="radio"/> Gravel Packed, <input type="radio"/> Underreamed, <input type="radio"/> Telescoped, <input checked="" type="radio"/> Natural Development, <input type="radio"/> Open Hole, <input type="radio"/> Other (Describe) _____		
Top of Lap Pipe or Reduction in Casing		
FEET	IF TELESCOPED OR MORE THAN ONE SCREEN: USE BACK PAGE	

<b>LOG DATA</b>	
TYPE OF LOG RUN (Circle One): Electric, Gamma Ray, Density, Sonic, Neutron, <input checked="" type="radio"/> No Log Run, Other (Describe) _____	
Name of Organization Running Log	

<b>SCREEN DATA</b>		
Diameter - Inches <b>2"</b>	Length - Feet <b>10'</b>	Slot Size - Inches <b>.0006</b>
Screen Type <b>PVC</b>	Depth to Bottom - Feet <b>300'</b>	

<b>GEOLOGIC DATA (Office Use Only)</b>			
Surface Elev.	Geologic Unit	Unit Thickness	Depth to Top
Subs. SWL	Date	Analysis	Aquifer Test

Driller's Remarks


RECEIVED

DESCRIPTION OF FORMATIONS ENCOUNTERED	FROM	TO	FORMATIONS (Continued)	FROM	TO
<b>Mud</b>	<b>0</b>	<b>20</b>	<div style="font-size: 1.5em; font-weight: bold;">JUN 17 1988</div> <div style="font-size: 0.8em; font-weight: bold;">Department of Natural Resources Bureau of Land &amp; Water Resources</div>		
<b>Sand</b>	<b>20</b>	<b>40</b>			
<b>Mud</b>	<b>40</b>	<b>230</b>			
<b>Sand</b>	<b>230</b>	<b>300</b>			

IF MORE SPACE IS NEEDED, USE BACK

If well telescopes please sketch and show depths.

GROUND LEVEL

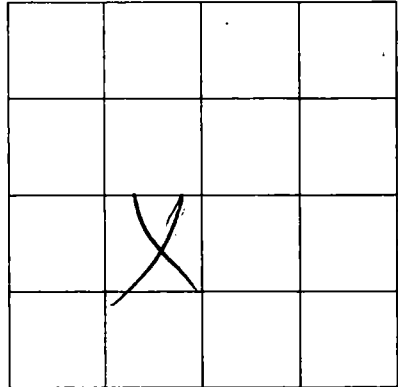

SECTION \_\_\_\_\_

Please indicate well location X.

ADDITIONAL INFORMATION

If more than one screen,  
show location of each on sketch.