

**MISSISSIPPI DEPARTMENT OF NATURAL RESOURCES**  
Bureau of Land and Water Resources

P.O. Box 10631  
Jackson, Mississippi 39209  
**WATER WELL DRILLERS LOG**

COUNTY WELL LOCATED <u>Harrison</u>	
WELL NUMBER <u>Φ 2208</u>	CODED
DATE WELL COMPLETED <u>July 1, 1988</u>	

PERMIT NUMBER <u>0239</u>
NAME OF DRILLING FIRM <u>McMill Pump + Wells</u>

NAME & MAILING ADDRESS OF LANDOWNER <u>Eddie Reid</u>		
<u>2011 W. 2nd Street</u>		
<u>Pass Christian MS.</u>		
WELL LOCATION:	SEC	TOWNSHIP RANGE
	<u>17</u>	<u>8</u> N <u>12</u> E
DISTANCE	DIRECTION	NEAREST TOWN
<u>3</u> Miles	<u>North</u>	of <u>Pass C.</u>
OTHER LANDMARK		
WELL PURPOSE: <input checked="" type="checkbox"/> Home Irrigation, <input type="checkbox"/> Municipal, <input type="checkbox"/> Industrial, <input type="checkbox"/> Fish Pond, etc.		

PUMP DATA		
PUMP TYPE (Circle One): Submersible, Turbine, <input checked="" type="radio"/> Flowing Well, Other (Describe) _____		
POWER TYPE (Circle One): <input checked="" type="radio"/> Electric, <input type="radio"/> Tractor, <input type="radio"/> Diesel, <input type="radio"/> Gasoline, <input type="radio"/> Butane, Other (Describe) _____		
Pump Capacity (GPM) <u>12</u>	No. of Stages <u>2</u>	Setting Depth <u>60'</u> FT.
PUMP TEST Well yielded <u>10</u> GPM with a drawdown of <u>10</u> ft. after <u>1</u> hours of pumping		


WELL DATA		
Well Depth <u>620'</u>	Casing Diameter (In.) <u>2"</u>	Casing Length (Fl.) <u>620'</u>
Type of Casing <u>PVC</u>	Hole Depth <u>620'</u>	Depth to Static Water Level <u>30'</u>
TYPE OF COMPLETION: (Circle One or More): <input checked="" type="checkbox"/> Gravel Packed, <input type="checkbox"/> Underreamed, <input type="checkbox"/> Telescoped, <input checked="" type="checkbox"/> Natural Development, <input type="checkbox"/> Open Hole, <input type="checkbox"/> Other (Describe) _____		
Top of Lap Pipe or Reduction in Casing		
FEET	IF TELESCOPED OR MORE THAN ONE SCREEN: USE BACK PAGE	

LOG DATA	
TYPE OF LOG RUN (Circle One): Electric, Gamma Ray, Density, Sonic, <input checked="" type="radio"/> No Log Run, Other (Describe) _____	
Name of Organization Running Log _____	

SCREEN DATA		
Diameter - Inches <u>2"</u>	Length - Feet <u>10'</u>	Slot Size - Inches <u>.0006</u>
Screen Type <u>PVC</u>		Depth to Bottom - Feet <u>620'</u>

GEOLOGIC DATA (Office Use Only)			
Surface Elev.	Geologic Unit	Unit Thickness	Depth to Top
Subs. SWL	Date	Analysis	Aquifer Test


Driller's Remarks	

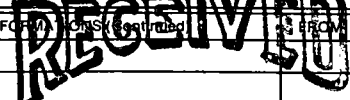DESCRIPTION OF FORMATIONS ENCOUNTERED	FROM	TO	FORMATIONS ENCOUNTERED	FROM	TO
<u>Sand</u>	<u>0</u>	<u>60</u>	 <u>SEP 19 1988</u> Department of Natural Resources Bureau of Land & Water Resources		
<u>Mud</u>	<u>60</u>	<u>100</u>			
<u>Sand</u>	<u>100</u>	<u>170</u>			
<u>mud</u>	<u>170</u>	<u>410</u>			
<u>sand</u>	<u>410</u>	<u>440</u>			
<u>mud</u>	<u>440</u>	<u>550</u>			
<u>Sand</u>	<u>550</u>	<u>620</u>			

IF MORE SPACE IS NEEDED, USE BACK

If well telescopes please sketch and show depths.

GROUND LEVEL

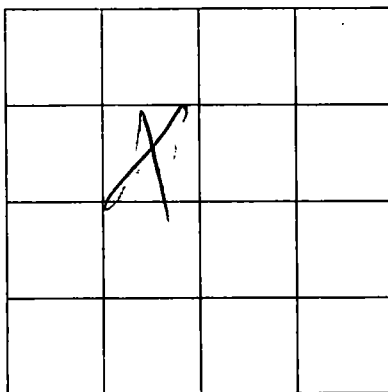

SECTION \_\_\_\_\_

Please indicate well location X.

ADDITIONAL INFORMATION

If more than one screen,  
show location of each on sketch.