

MISSISSIPPI DEPARTMENT OF NATURAL RESOURCES
Bureau of Land and Water Resources

P.O. Box 10631
Jackson, Mississippi 39209
WATER WELL DRILLERS LOG

COUNTY WELL LOCATED
Harrison

WELL NUMBER **Φ 2213** CODED

DATE WELL COMPLETED
6-28-88

PERMIT NUMBER **0-239**

NAME OF DRILLING FIRM
McGill Pump

Φ WELL

NAME & MAILING ADDRESS OF LANDOWNER
Norothy Prince
402 Waltham
Wupst, Ms.

WELL LOCATION SEC **17** TOWNSHIP **8** RANGE **N 12 E**

DISTANCE **1** Miles DIRECTION **South** of NEAREST TOWN **Pinerville**

OTHER LANDMARK

WELL PURPOSE: Home, Irrigation, Municipal, Industrial, Fish Pond, etc.
home

PUMP DATA

PUMP TYPE (Circle One):
Submersible, Turbine, **Jet** Flowing Well,
Other (Describe) _____

POWER TYPE (Circle One):
Electric, Tractor, Diesel, Gasoline, Butane,
Other (Describe) _____

Pump Capacity (GPM) **15** No. of Stages **2** Setting Depth **60** FT.

PUMP TEST
Well yielded **15** GPM with
a drawdown of **10** ft.
after **1** hours of pumping

WELL DATA

Well Depth 640	Casing Diameter (In.) 2	Casing Length (Ft.) 20
Type of Casing DVC	Hole Depth 640	Depth to Static Water Level 30'

TYPE OF COMPLETION: (Circle One or More):
~~Gravel Packed,~~ Underreamed, Telescoped,
~~Natural Development,~~ Open Hole, Other
(Describe) _____

Top of Lap Pipe or Reduction in Casing
FEET IF TELESCOPED OR MORE THAN ONE SCREEN: USE BACK PAGE

LOG DATA

TYPE OF LOG RUN (Circle One): **No Log Run**,
Electric, Gamma Ray, Density, Sonic, Neutron,
Other (Describe) _____

Name of Organization Running Log

SCREEN DATA

Diameter - Inches 2	Length - Feet 10	Slot Size - Inches 6
Screen Type DVC	Depth to Bottom - Feet 630	

GEOLOGIC DATA (Office Use Only)

Surface Elev.	Geologic Unit	Unit Thickness	Depth to Top
Subs. SWL	Date	Analysis	Aquifer Test

Driller's Remarks


DESCRIPTION OF FORMATIONS ENCOUNTERED	FROM	TO	FORMER (continued)	TO
Sand	0	60		
mud	60	110		
sand	110	160		
mud	160	380		
Sand	380	420		
mud	420	570		
sand	570	640		

RECEIVED
NOV 30 1988
Department of Natural Resources
Bureau of Land & Water Resources

IF MORE SPACE IS NEEDED, USE BACK

If well telescopes please sketch and show depths.

GROUND LEVEL

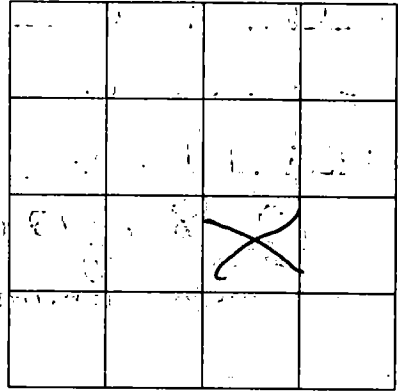

SECTION _____

Please indicate well location X.

ADDITIONAL INFORMATION

Multiple horizontal lines for additional information.

RECEIVED

NOV 23 1988

U.S. GEOLOGICAL SURVEY
WATER RESOURCES DIVISION
FEDERAL BUREAU OF INVESTIGATION

If more than one screen, show location of each on sketch.