

**MISSISSIPPI DEPARTMENT OF NATURAL RESOURCES**

Bureau of Land and Water Resources

P.O. Box 10631

Jackson, Mississippi 39209

**WATER WELL DRILLERS LOG**

COUNTY WELL LOCATED <i>Harrison</i>	
WELL NUMBER <i>Q 2217</i>	CODED
DATE WELL COMPLETED <i>11-8-88</i>	

PERMIT NUMBER <i>D-493</i>
NAME OF DRILLING FIRM <i>Bobby Beach's Well Works</i>

NAME & MAILING ADDRESS OF LANDOWNER <i>(Paul) Cable Com English</i>		
<i>23125 Montebella Rd.</i>		
<i>Q. c. ms.</i>		
WELL LOCATION: SEC	TOWNSHIP	RANGE
<i>17</i>	<i>8</i>	<i>N 12 E</i>
DISTANCE	DIRECTION	NEAREST TOWN
_____ Miles	_____ of	_____
OTHER LANDMARK		
WELL PURPOSE: <u>Home</u> Irrigation, Municipal, Industrial, Fish Pond, etc.		

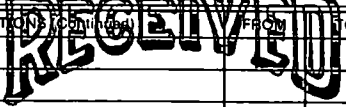
PUMP DATA		
PUMP TYPE (Circle One): <u>Submersible</u> , Turbine, Jet, Flowing Well, Other (Describe) _____		
POWER TYPE (Circle One): <u>Electric</u> , Tractor, Diesel, Gasoline, Butane, Other (Describe) _____ H/P _____		
Pump Capacity (GPM)	No. of Stages	Setting Depth  FT.
PUMP TEST		
Well yielded _____ GPM with a drawdown of _____ ft. after _____ hours of pumping		

WELL DATA		
Well Depth <i>457</i>	Casing Diameter (In.) <i>4"</i>	Casing Length (Ft.) <i>20</i>
Type of Casing <i>PVC</i>	Hole Depth <i>457</i>	Depth to Static Water Level
TYPE OF COMPLETION: (Circle One or More): <u>Natural Development</u> , Gravel Packed, Underreamed, Telescoped, Open Hole, Other		
Top of Lap Pipe or Reduction in Casing		
FEET	IF TELESCOPED OR MORE THAN ONE SCREEN: USE BACK PAGE	

LOG DATA			
TYPE OF LOG RUN (Circle One): <u>No Log Run</u> Electric, Gamma Ray, Density, Sonic, Neutron, Other (Describe) _____			
Name of Organization Running Log <i>Bobby Beach's Well Works</i>			
GEOLOGIC DATA (Office Use Only)			
Surface Elev.	Geologic Unit	Unit Thickness	Depth to Top
Subs. SWL	Date	Analysis	Aquifer Test

SCREEN DATA		
Diameter - Inches <i>4"</i>	Length - Feet <i>20</i>	Slot Size - Inches <i>#8</i>
Screen Type <i>Johnson Screens</i>	Depth to Bottom - Feet	

Driller's Remarks <i>Fine Well</i>
---------------------------------------

DESCRIPTION OF FORMATIONS ENCOUNTERED	FROM	TO	FORMATION (Continued)	FROM	TO
 <b>JUN 6 1989</b> Department of Natural Resources Bureau of Land & Water Resources					
IF MORE SPACE IS NEEDED, USE BACK					

