

MISSISSIPPI DEPARTMENT OF NATURAL RESOURCES

Bureau of Land and Water Resources

P.O. Box 10631

Jackson, Mississippi 39209

WATER WELL DRILLERS LOG

COUNTY WELL LOCATED <i>Harrison</i>	
WELL NUMBER <i>Φ 2002</i>	CODED
DATE WELL COMPLETED <i>9/12/88</i>	

PERMIT NUMBER <i>01010</i>	NAME OF DRILLING FIRM <i>Bob's Drilling</i>
<i>14 Woodmark of Rd</i>	
<i>Bibi, Ms 39532</i>	

NAME & MAILING ADDRESS OF LANDOWNER <i>Best Davis</i>			
<i>12441 Mergel Ave</i>			
<i>Jess Christian, Ms</i>			
WELL LOCATION:	SEC	TOWNSHIP	RANGE
	<i>17</i>	<i>8</i>	<i>12</i>
		<i>S</i>	<i>W</i>
DISTANCE	DIRECTION	NEAREST TOWN	
<i>None</i>	<i>North</i>	<i>Woodmark</i>	
OTHER LANDMARK <i>Indian Bayou</i>			
WELL PURPOSE: Home, Irrigation, Municipal, Industrial, Fish Pond, etc. <i>Home</i>			

PUMP DATA		
PUMP TYPE (Circle One): Submersible, Turbine, <input checked="" type="radio"/> Jet, Flowing Well, Other (Describe) _____		
POWER TYPE (Circle One): <input checked="" type="radio"/> Electric, Tractor, Diesel, Gasoline, Butane, Other (Describe) _____		
Pump Capacity (GPM) <i>12</i>	No. of Stages <i>2</i>	Setting Depth <i>40</i> FT.
PUMP TEST		
Well yielded <i>12</i> GPM with a drawdown of <i>0</i> ft. after <i>6</i> hours of pumping		

WELL DATA		
Well Depth <i>620'</i>	Casing Diameter (In.) <i>4 1/2"</i>	Casing Length (Ft.) <i>600'</i>
Type of Casing <i>4 1/2"</i>	Hole Depth <i>620'</i>	Depth to Static Water Level <i>10'</i>
TYPE OF COMPLETION: (Circle One or More): <input checked="" type="checkbox"/> Gravel Packed, <input type="checkbox"/> Underreamed, <input type="checkbox"/> Telescoped, <input checked="" type="checkbox"/> Natural Development, <input type="checkbox"/> Open Hole, <input type="checkbox"/> Other (Describe) _____		
Top of Lap Pipe or Reduction in Casing FEET IF TELESKOPED OR MORE THAN ONE SCREEN: USE BACK PAGE		


LOG DATA	
TYPE OF LOG RUN (Circle One): Electric, Gamma Ray, Density, Sonic, <input checked="" type="radio"/> No Log Run, Neutron, Other (Describe) _____	
Name of Organization Running Log _____	

SCREEN DATA		
Diameter - Inches <i>2"</i>	Length - Feet <i>20</i>	Slot Size - Inches <i>.006</i>
Screen Type <i>4 1/2" Saw</i>	Depth to Bottom - Feet <i>620'</i>	

GEOLOGIC DATA (Office Use Only)			
Surface Elev.	Geologic Unit	Unit Thickness	Depth to Top
Subs. SWL	Date	Analysis	Aquifer Test

Driller's Remarks <i>None</i>

DESCRIPTION OF FORMATIONS ENCOUNTERED	FROM	TO
<i>Topsoil</i>	<i>1</i>	<i>2</i>
<i>Brannford</i>	<i>2</i>	<i>12</i>
<i>Coal with Sand</i>	<i>12</i>	<i>60</i>
<i>Coarse sand, clay, sh</i>	<i>100</i>	<i>210</i>
<i>fine water sand</i>	<i>210</i>	<i>230</i>
<i>soft blue clay</i>	<i>230</i>	<i>310</i>
<i>hard blue clay</i>	<i>310</i>	<i>510</i>
<i>fine water sand</i>	<i>510</i>	<i>550</i>
<i>fine water sand</i>	<i>550</i>	<i>620</i>

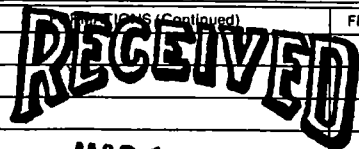

MAR 15 1991

Dept. of Environmental Quality
Bureau of Land & Water Resources

IF MORE SPACE IS NEEDED, USE BACK

If well telescopes please sketch and show depths.

GROUND LEVEL

X			

SECTION _____

Please indicate well location X.

ADDITIONAL INFORMATION

RECEIVED

If more than one screen, show location of each on sketch.