

MISSISSIPPI DEPARTMENT OF NATURAL RESOURCES

Bureau of Land and Water Resources

P.O. Box 10631

Jackson, Mississippi 39209

WATER WELL DRILLERS LOG

COUNTY WELL LOCATED HARRISON	
WELL NUMBER Φ	CODED
2239	
DATE WELL COMPLETED 1-11-90	

PERMIT NUMBER 0239
NAME OF DRILLING FIRM McBee

NAME & MAILING ADDRESS OF LANDOWNER		
Arcadia rd.		
Pass Chr, Ms.		
WELL LOCATION: SEC	TOWNSHIP	RANGE
18	8	12
	N	E
	S	W
DISTANCE 2 Miles	DIRECTION South of	NEAREST TOWN Renewille
OTHER LANDMARK		
WELL PURPOSE <input checked="" type="radio"/> Home <input type="radio"/> Irrigation, <input type="radio"/> Municipal, <input type="radio"/> Industrial, <input type="radio"/> Fish Pond, etc.		

PUMP DATA		
PUMP TYPE (Circle One): Submersible, Turbine, Jet, Flowing Well, Other (Describe) <u>suction</u>		
POWER TYPE (Circle One): <input checked="" type="radio"/> Electric, <input type="radio"/> Tractor, <input type="radio"/> Diesel, <input type="radio"/> Gasoline, <input type="radio"/> Butane, Other (Describe)		
Pump Capacity (GPM) 10	No. of Stages 1	Setting Depth 20 FT.
PUMP TEST		
Well yielded 10 GPM with a drawdown of 1 ft. after 1 hours of pumping		

WELL DATA		
Well Depth 300	Casing Diameter (In.) 2	Casing Length (Ft.) 290
Type of Casing pc	Hole Depth 29	Depth to Static Water Level 300
TYPE OF COMPLETION: (Circle One or More): <input checked="" type="radio"/> Gravel Packed, <input type="radio"/> Underreamed, <input type="radio"/> Telescoped, <input checked="" type="radio"/> Natural Development, <input type="radio"/> Open Hole, <input type="radio"/> Other		
Top of Lap Pipe or Reduction in Casing		
FEET		
IF TELESCOPED OR MORE THAN ONE SCREEN: USE BACK PAGE		

LOG DATA	
TYPE OF LOG RUN (Circle One): <input checked="" type="radio"/> No Log Run <input type="radio"/> Electric, <input type="radio"/> Gamma Ray, <input type="radio"/> Density, <input type="radio"/> Sonic, <input type="radio"/> Neutron, Other (Describe)	
Name of Organization Running Log	

SCREEN DATA		
Diameter - Inches 2	Length - Feet 10	Slot Size - Inches .0006
Screen Type pc	Depth to Bottom - Feet 300	

GEOLOGIC DATA (Office Use Only)			
Surface Elev.	Geologic Unit	Unit Thickness	Depth to Top
Subs. SWL	Date	Analysis	Aquifer Test
Driller's Remarks			

DESCRIPTION OF FORMATIONS ENCOUNTERED	FROM	TO
Mud	0	160
Mud, SAND	160	280
SAND	280	300

FORMATIONS (Continued)	FROM	TO
RECEIVED		
DEC 02 1991		
Dept. of Environmental Quality		
Bureau of Land & Water Resources		
IF MORE SPACE IS NEEDED, USE BACK		

If well telescopes please sketch and show depths.


GROUND LEVEL

	X		

SECTION _____

Please indicate well location X.

ADDITIONAL INFORMATION

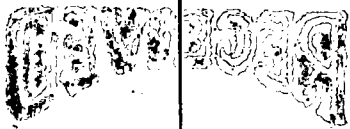

NO. 90 330

NO. 90 330
CERAMIC TILE & STAINLESS STEEL

If more than one screen,
show location of each on sketch.