

MISSISSIPPI DEPARTMENT OF ENVIRONMENTAL QUALITY
Bureau of Land and Water Resources

P. O. Box 10631
Jackson, MS 39289-0631
WATER WELL DRILLERS LOG

COUNTY WELL LOCATED <i>Harrison</i>	
WELL NUMBER <i>0 2241</i>	CODED
DATE WELL COMPLETED <i>8-29-89</i>	

PERMIT NUMBER
NAME OF DRILLING FIRM Coastal Drilling & Service Co. 8456 Woodmarket Biloxi Road Biloxi, Mississippi 39532

NAME & MAILING ADDRESS OF LANDOWNER <i>Jim Hall</i> <i>805 Scenic Drive</i> <i>Pass Christian</i>			
WELL LOCATION:	SEC	TOWNSHIP	RANGE
<i>Harrison 30</i>	<i>8</i>	<i>N 12 E</i>	<i>W</i>
DISTANCE	DIRECTION	NEAREST TOWN	
		<i>Pass Christian</i>	
OTHER LANDMARK <i>Highway 90</i>			
WELL PURPOSE: Home Irrigation, Municipal, Industrial, Fish Pond, etc.			


PUMP DATA		
PUMP TYPE (Circle One): <input checked="" type="radio"/> Submersible, <input type="radio"/> Turbine, <input type="radio"/> Jet <input type="radio"/> Flowing Well, Other (Describe) _____		
POWER TYPE (Circle One): <input checked="" type="radio"/> Electric, <input type="radio"/> Tractor, <input type="radio"/> Diesel, <input type="radio"/> Gasoline, <input type="radio"/> Butane, Other (Describe) _____ H/P _____		
Pump Capacity (GPM) <i>80</i>	No. of Stages <i>18</i>	Setting Depth <i>60 FT.</i>
PUMP TEST		
Well yielded _____ <i>80</i> GPM with a drawdown of _____ <i>2</i> ft. after _____ <i>6</i> hours of pumping		

WELL DATA		
Well Depth <i>780'</i>	Casing Diameter (In.) <i>4"</i>	Casing Length (Ft.) <i>740'</i>
Type of Casing <i>GAL.</i>	Hole Depth <i>780'</i>	Depth to Static Water Level <i>40</i>
TYPE OF COMPLETION: (Circle One or More): <input checked="" type="radio"/> Gravel Packed, <input type="radio"/> Underreamed, <input type="radio"/> Telescoped, <input checked="" type="radio"/> Natural Development, <input type="radio"/> Open Hole, <input type="radio"/> Other (Describe) _____		
Top of Lap Pipe or Reduction in Casing FEET IF TELESCOPED OR MORE THAN ONE SCREEN: USE BACK PAGE		

LOG DATA	
TYPE OF LOG RUN (Circle One): <input type="radio"/> No Log Run, <input type="radio"/> Electric, <input type="radio"/> Gamma Ray, <input type="radio"/> Density, <input type="radio"/> Sonic, <input type="radio"/> Neutron, Other (Describe) _____	
Name of Organization Running Log	


SCREEN DATA		
Diameter - Inches <i>4"</i>	Length - Feet <i>40</i>	Slot Size - Inches <i>.010</i>
Screen Type <i>ST. STEEL</i>	Depth to Bottom - Feet <i>780</i>	

GEOLOGIC DATA (Office Use Only)			
Surface Elev.	Geologic Unit	Unit Thickness	Depth to Top
Subs. SWL	Date	Analysis	Aquifer Test
Driller's Remarks <i>None</i>			

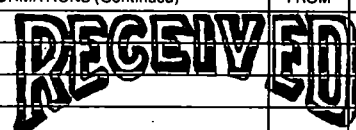DESCRIPTION OF FORMATIONS ENCOUNTERED	FROM	TO	FORMATIONS (Continued)	FROM	TO
 MAR 02 1992 Dept. of Environmental Quality Bureau of Land & Water Resources					
IF MORE SPACE IS NEEDED, USE BACK					

If well telescopes please sketch and show depths.

GROUND LEVEL

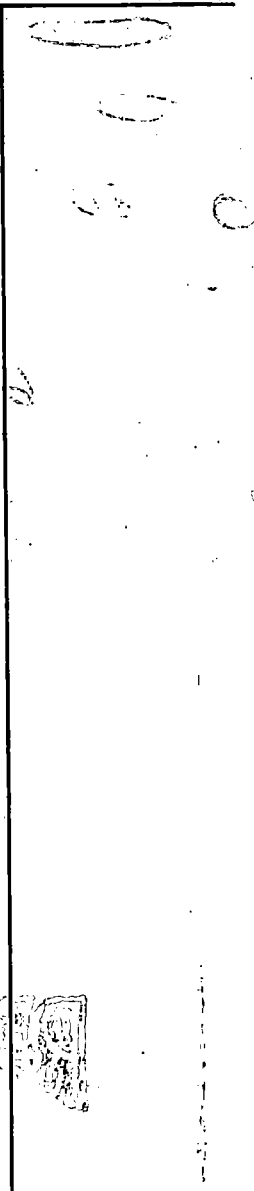

1	2	3	4
5	6	7	8
9	10	11	12
13	14	15	16

SECTION _____

Please indicate well location X.

ADDITIONAL INFORMATION

Handwritten notes and scribbles in the additional information section, including the number '10' and other illegible markings.

DAVIDSON

SEP 14 1950

FIELD INFORMATION IS TO BE
RECORDED WITH ORIGINAL RECORD

If more than one screen,
show location of each on sketch.