




If well telescopes please sketch and show depths.

GROUND LEVEL

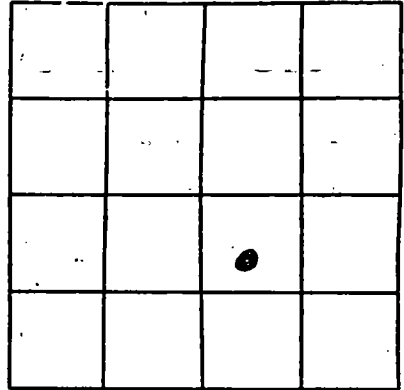

SECTION \_\_\_\_\_

Please indicate well location X.

Pump Capacity (GPM) <u>11.7</u>	No. of Stages <u>2</u>	Setting Depth <u>160</u> FT.
PUMP TEST		
Well yielded <u>11.7</u> GPM with a drawdown of <u>5</u> ft. after <u>5</u> hours of pumping		

LOG DATA

TYPE OF LOG RUN (Circle One):      No Log Run.  
 Electric, Gamma Ray, Density, Sonic, Neutron,  
 Other (Describe) handwritten

Name of Organization Running Log \_\_\_\_\_

GEOLOGIC DATA (Office Use Only)

Surface Elev.	Geologic Unit	Unit Thickness	Depth to Top
Subs. SWL	Date	Analysis	Aquifer Test

Driller's Remarks

\_\_\_\_\_

\_\_\_\_\_

If more than one screen,  
show location of each on sketch.