

**MISSISSIPPI
BOARD OF WATER COMMISSIONERS**
416 North State Street
Jackson, Mississippi 39201

CODED

WATER WELL DRILLERS LOG

Harrison
01
9-67
GW 02050

date well completed 9-27 1967 firm name Switzer Well Co. county well located Harrison


LANDOWNER	description of formations encountered	from	to
<u>Coast Waterworks</u>			
<u>DeCan Park Subdivision</u>	<u>sand</u>	<u>0</u>	<u>26</u>
<u>Long Beach, Miss.</u>	<u>sand + gravel</u>	<u>26</u>	<u>49</u>
(mailing address)	<u>sand</u>	<u>49</u>	<u>60</u>
	<u>clay</u>	<u>60</u>	<u>70</u>
	<u>mixed</u>	<u>70</u>	<u>82</u>
	<u>clay</u>	<u>82</u>	<u>157</u>
	<u>mixed</u>	<u>157</u>	<u>201</u>
	<u>clay</u>	<u>201</u>	<u>287</u>
	<u>mixed</u>	<u>287</u>	<u>309</u>
	<u>clay</u>	<u>309</u>	<u>433</u>
	<u>sand</u>	<u>433</u>	<u>443</u>
	<u>fair sand</u>	<u>443</u>	<u>461</u>
	<u>clay</u>	<u>461</u>	<u>487</u>
	<u>mixed</u>	<u>487</u>	<u>525</u>
	<u>clay</u>	<u>525</u>	<u>571</u>
	<u>sand</u>	<u>571</u>	<u>573</u>
	<u>mixed</u>	<u>573</u>	<u>586</u>
	<u>fair sand</u>	<u>586</u>	<u>594</u>
	<u>good sand</u>	<u>594</u>	<u>654</u>

LANDOWNER: Coast Waterworks
DeCan Park Subdivision
Long Beach, Miss.
(mailing address)

WELL LOCATION:
sec. 10 T. 8 N. R. 12 W.
4 miles NW of LONG BEACH
(distance) (direction) (nearest town)

WELL PURPOSE: Municipal
(home, irrigation, municipal, industrial)

- WELL COMPLETION DATA:
- (1) diameter (inches) 10x6
 - (2) total depth (feet) 654
 - (3) static water level (feet) 1 below top of ground
 - (4) casing gal. steel, 594' (material) (depth)
10x6 104' of 10" (size) If telescope see back.
 - (5) screen 60' (length), 594' (depth to top)
800, SS on pipe (size) (material)
 - (6) pump 20 (HP), 250 (yield gpm)
electric (type power)
 - (7) electric log No (yes or no)
(organization running log)
 - (8) how well bottom plugged back pressure valve

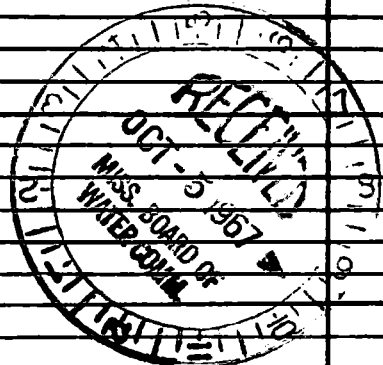

DRILLERS REMARKS:

If well telescopes please sketch and show depths.

GROUND LEVEL

X			

SECTION 10

Please indicate well location X.

ADDITIONAL INFORMATION

If more than one screen, show locations of each on sketch.