

HAR.

WATER WELL DRILLERS LOG

0-300

10-21-60


Date: Oct. 21, 1960, Driller: C.T. Lutzger Well Co. County Harrison
(Name)

	Description & Color of Materials Sand, Clay, Red Clay, Shell, etc.	Thick- ness Feet	Depth Feet
(1) Owner of Land: <u>Julian Inahan</u> <u>Corner of Seal Road & Railroad</u> <u>Street, Long Beach, Miss.</u> <small>(Address)</small>	sand	0	45
(2) Location: <u>1/4</u> , <u>1/4</u> , Sec. <u>T</u> <u>R</u>	Clay	45	49
<u>1</u> miles <u>W.</u> of <u>Long Beach</u> <small>(distance) (direction) (Nearest Town)</small>	sand	49	106
(3) Topography: <input checked="" type="checkbox"/> (Hilly) <input type="checkbox"/> (Flat) <input type="checkbox"/> (Level)	Clay	106	459
(4) Purpose of Well: <u>Domestic</u> <small>(Domestic Irrigation Municipal, Industrial, Other)</small>	sand	459	493

Information upon completion of well:

- (1) Diameter 2 inches.
- (2) Total Depth 493 feet.
- (3) Water Level -4' 7" feet below top of ground.
- (4) Cased to 493', Size 2"
- (5) Screen: Size 8ga 55, Length 10'
- (6) Were any formations sealed against pollution?
 yes, no.

If YES depth of formation 10 feet
 Why Health Dept. requirement
 Drillers Remarks: _____

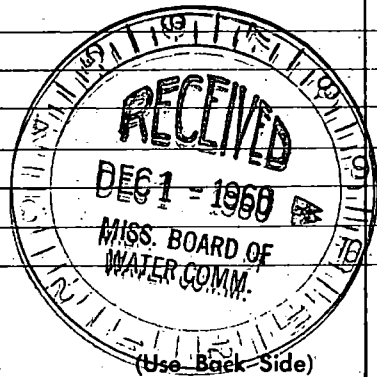

Well No.

