

HAR.

MISSISSIPPI BOARD OF WATER COMMISSIONERS

1-5-61

WATER WELL DRILLERS LOG

0-315

Date: 1-5, 1961, Driller: *see Miller?*

County

(Name)

(1) Owner of Land: *Ed Hatem*
(Name)
RR# Long Beach Miss
(Address)

(2) Location: $\frac{1}{4}$, $\frac{1}{4}$, Sec. T R
miles of
(distance) (direction) (Nearest Town)

(3) Topography: *Flat*
(Hilly) (Flat) (Level)

(4) Purpose of Well: *Domestic*
(Domestic Irrigation
Municipal, Industrial, Other)

Description & Color of Materials Sand, Clay, Red Clay, Shell, etc.	Thick- ness Feet	Depth Feet
<i>Surface</i>	<i>3</i>	<i>3</i>
<i>wh Sand</i>	<i>21</i>	<i>24</i>
<i>Clay Blue & Gray</i>	<i>112</i>	<i>136</i>
<i>Fine Sands & Cl. NG</i>	<i>45</i>	<i>181</i>
<i>hd Clay, Blue</i>	<i>381</i>	<i>562</i>
<i>Small Br.</i>	<i>3</i>	<i>565</i>
<i>hd Cl.</i>	<i>100</i>	<i>665</i>
<i>fine gray sand</i>	<i>17</i>	<i>682</i>
<i>Gray Sand (Fair)</i>	<i>42</i>	<i>724</i>
<i>" " Red</i>	<i>21</i>	<i>745</i>
<i>" " Red Sand</i>	<i>31</i>	<i>776</i>

Information upon completion of well:

- (1) Diameter *2"* inches.
- (2) Total Depth *776'* feet.
- (3) Water Level *Flowing* feet below top of ground.
- (4) Cased to *756*, Size *2"*
- (5) Screen: Size *2"*, Length *20*
- (6) Were any formations sealed against pollution?


yes, no.

If YES depth of formation *10'*

Why *7th A Ruling*

Drillers Remarks:

Still in Sand

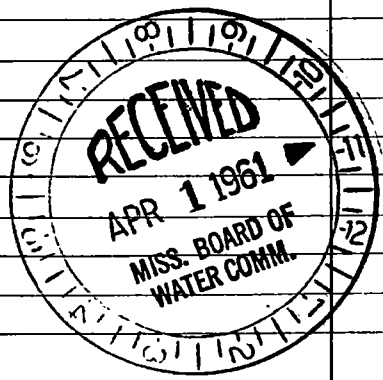

(Use Back Side)

Well No.

S-

Long Beach

Ed Hatten

Commission Rd

Alondike Rd

28 St.

E

-W

N-

