

HAR.

MISSISSIPPI BOARD OF WATER COMMISSIONERS

0-309

3-17-61

WATER WELL DRILLERS LOG

Date: 3/17, 19\_\_\_, Driller: Hittieburg Butare County Harrison  
(Name)

- (1) Owner of Land: Sam Jones  
(Name)  
Long Beach Mrs  
(Address)  
Commission Rd
- (2) Location: \_\_\_ 1/4, \_\_\_ 1/4, Sec. \_\_\_ T \_\_\_ R \_\_\_  
4 miles north of Long Beach  
(distance) (direction) (Nearest Town)
- (3) Topography: Level  
(Hilly) (Flat) (Level)
- (4) Purpose of Well: Domestic  
(Domestic Irrigation  
Municipal, Industrial, Other)

Description & Color of Materials Sand, Clay, Red Clay, Shell, etc.	Thick- ness Feet	Depth Feet
<u>White sand</u>	<u>0 - 30</u>	
<u>Blue clay</u>	<u>30 - 80</u>	
<u>Blue sand</u>	<u>80 - 90</u>	
<u>Blue clay</u>	<u>90 - 180</u>	
<u>Blue sand</u>	<u>180 - 203</u>	


Information upon completion of well:

- (1) Diameter 2 inches.
- (2) Total Depth 203 feet.
- (3) Water Level 18 feet below top of ground.
- (4) Cased to \_\_\_\_\_, Size \_\_\_\_\_
- (5) Screen: Size 2", Length 10"
- (6) Were any formations sealed against pollution?  
\_\_\_\_\_ yes, X no.

If YES depth of formation \_\_\_\_\_

Why \_\_\_\_\_

Drillers Remarks: \_\_\_\_\_

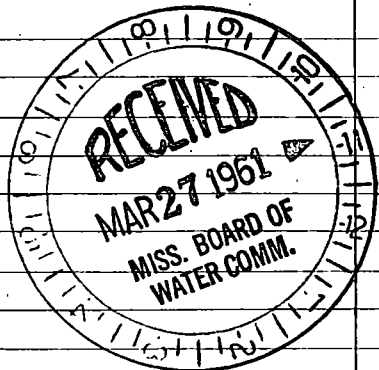

(Use Back Side)

Well No.

