

HAR.

WATER WELL DRILLERS LOG

0-317

Date: Apr 4-61, 19 61, Driller: Joe Miller County Harrison
(Name)

(1) Owner of Land: Doc Scarborough
(Name)
Rt 1 Long Beach, Miss
(Address)

(2) Location: 2 miles North of Long Beach
(distance) (direction) (Nearest Town)

(3) Topography: Flat
(Hilly) (Flat) (Level)

(4) Purpose of Well: Domestic
(Domestic Irrigation
Municipal, Industrial, Other)

Description & Color of Materials Sand, Clay, Red Clay, Shell, etc.	Thick- ness Feet	Depth Feet
Surface	5	5
Wh. Sd.	33	38
Blue Cl.	200	238
Fine Gr. Bl. Sd. ^{WG}	7	245
Blk. Cl.	125	370
Soft Sp. Sd.	8	378
Red Hat Cl. Blue	14	392
Fine Blue Sd.	18	410
Hd. Cl. Sm. Br.	27	437
Fine Sand	3	440
Sand Fair	22	462
Sand Good	25	477

Information upon completion of well:

(1) Diameter 2 inches.

(2) Total Depth 477 feet.

(3) Water Level 41 feet below top of ground.

(4) Cased to 466, Size 2"

(5) Screen: Size 2", Length 10'


(6) Were any formations sealed against pollution?
_____ yes, _____ no.

Hd. Clay

If YES depth of formation _____

Why _____

Drillers Remarks: Pump 2000 GPH
294 Air

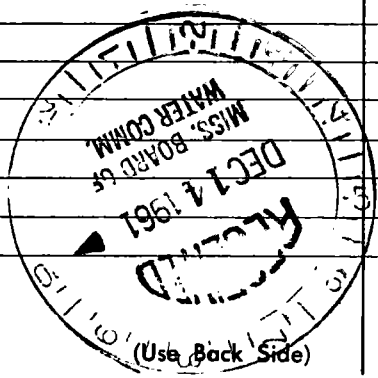

Well No.

Lou Beach Mass

Well

Commission Rd.

Klondike Rd

28 ft