

HAR.

MISSISSIPPI BOARD OF WATER COMMISSIONERS

7-12-61

WATER WELL DRILLERS LOG

?

Date: 7-12, 1961, Driller: Lutter Well Works County Harrison

(Name)

(1) Owner of Land: E. J. McCants
 (Name)
Pineville Rd. - Long Beach
 (Address)

(2) Location: 1/4, 1/4, Sec. 1 T. R,
3 miles NW of Long Beach,
 (distance) (direction) (Nearest Town)

(3) Topography: flat
 (Hilly) (Flat) (Level)

(4) Purpose of Well: domestic
 (Domestic Irrigation
 Municipal, Industrial, Other)

Description & Color of Materials Sand, Clay, Red Clay, Shell, etc.	Thick-ness Feet	Depth Feet
<u>Surface sand</u>	<u>4</u>	<u>4</u>
<u>sand</u>	<u>37</u>	<u>41</u>
<u>Clay</u>	<u>421</u>	<u>462</u>
<u>sand</u>	<u>28</u>	<u>490</u>

Information upon completion of well:

(1) Diameter 2 inches.

(2) Total Depth 490 feet.

(3) Water Level 4 feet below top of ground.

(4) Cased to all, Size 2"


(5) Screen: Size 2", Length 10'

(6) Were any formations sealed against pollution?
no

If YES depth of formation _____

Why _____

Drillers Remarks: _____

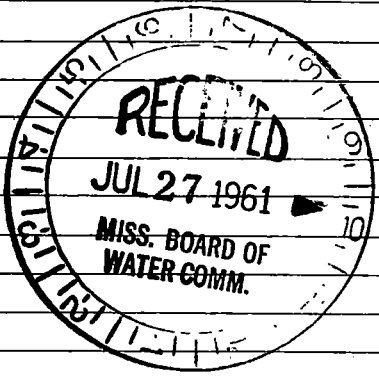

Well No.

(Use Back Side)

Handwritten text at the top of the page, including the word "Lecture" and other illegible characters.

Second section of handwritten text, appearing as a list or series of notes.

Third section of handwritten text, continuing the notes or list.

Bottom section of handwritten text, including some faint markings and possibly a signature.