

HAR.

7-25-61

WATER WELL DRILLERS LOG

Date: July 25 1961, Driller: J. E. Miller County Harrison

(1) Owner of Land: Jones, P. Gufford
 (Name)
 (Address)

(2) Location: 1/4, 1/4, Sec. T R
 1 miles North of Long Beach
 (distance) (direction) (Nearest Town)

(3) Topography: Flat
 (Hilly) (Flat) (Level)

(4) Purpose of Well: Domestic
 (Domestic Irrigation
 Municipal, Industrial, Other)

Description & Color of Materials Sand, Clay, Red Clay, Shell, etc.	Thick- ness Feet	Depth Feet
Surface	5	5
Black Sand	14	24
Blue Cl.	8	32
Sand + Cl. Break	13	45
Blue Cl.	85	130
Sand, N @ fine	12	142
Blue Cl. fine	60	202
Sand Break + Cl.	10	212
Thick Blue Cl. fine	76	288
Sand Break + Cl.	18	306
Red Cl. Blue Break	57	363
Fine Sand Heavy	9	372
Sand, Fair	10	382
Sand Break	11	393
Sand Break	9	502
Clay	2	504

Information upon completion of well:

(1) Diameter 2 inches.

(2) Total Depth 504 feet.

(3) Water Level 10" feet below top of ground.

(4) Cased to 492, Size 2"


(5) Screen: Size 2", Length 10"

(6) Were any formations sealed against pollution?
 yes, no.

If YES depth of formation

Why

Drillers Remarks:

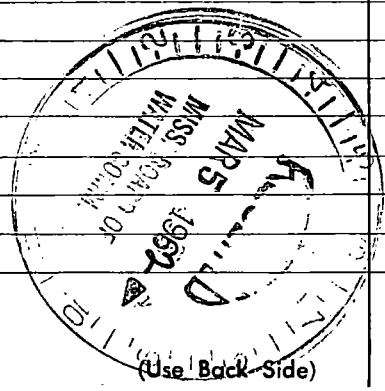

Well No.

28th

Jones

Long
Beak

Blondyke Rd

Long Beak

