

WATER WELL DRILLERS LOG

0-320

12-4-61

Date: Dec 4, 19 61, Driller: C. T. SWITZER WELL CO. County: Harrison

(Name)

(1) Owner of Land: W. D. Yarbrough
(Name)
Rt. 1, Box 538 - Gulfport
(Address)

(2) Location: 1/4, 1/4, Sec. T. R.
 miles of
(distance) (direction) (Nearest Town)

(3) Topography: X
(Hilly) (Flat) (Level)

(4) Purpose of Well: Domestic
(Domestic Irrigation
Municipal, Industrial, Other)

Description & Color of Materials Sand, Clay, Red Clay, Shell, etc.	Thick- ness Feet	Depth Feet
Clay	00	10
Sand	10	20
Clay	20	41
good, Sand	41	56
Clay	56	83
good, Sand	83	104
Clay	104	290
Sand	290	293
fine, Sand	293	298
Clay	298	356
fine, Sand	356	366
Clay	366	398
fine, Sand	398	413
Clay	413	440
fine, Sand	440	461
fine, Sand	461	482
Sand	482	492
Clay	492	522
good, Sand	522	567

Information upon completion of well:

(1) Diameter 2 inches.

(2) Total Depth 567 feet.


(3) Water Level 2' + feet below top of ground.

(4) Cased to 567', Size 2"

(5) Screen: Size 2", Length 10'

(6) Were any formations sealed against pollution?
 yes, no.

If YES depth of formation
Why Health Dept. Requirement
Drillers Remarks:

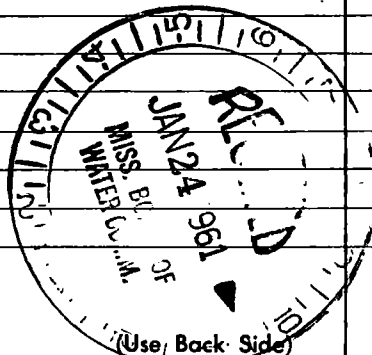

Well No.

WATER WELL DRILLERS LOG

H.A.R.

1922

Location of Well

(1) Owner of Land

(2) Location

(3) Topography

(4) Purpose of Well

(5) Diameter

(6) Total Depth

(7) Water Level

(8) Cased to

(9) Screen Size

(10) Were any formations noted during drilling?

If YES depth of formation

Remarks

Vertical column of handwritten notes on the left side of the log.

Main body of handwritten notes in the left column, detailing well information.

Main body of handwritten notes in the right column, detailing well information.

WELL NO.