

MISSISSIPPI
BOARD OF WATER COMMISSIONERS
416 North State Street
Jackson, Mississippi 39201

WATER WELL DRILLERS LOG

HINDS
A 2000
12-67

Dec. 31 1967 W.G. Butler Hinds
date well completed firm name county well located

LANDOWNER: R.E. HALLMAN
Balton, Miss.
(mailing address)


WELL LOCATION:
sec. 12 T. 7 N. R. 3 E
(distance) miles (direction) of (nearest town)

WELL PURPOSE: Home
(home, irrigation, municipal, industrial)

WELL COMPLETION DATA:

- (1) diameter (inches) 2"
- (2) total depth (feet) 262'
- (3) static water level (feet) 100' ^{below} above top of ground.
- (4) casing galv. 294' 257' (material) (depth)
2" if telescope see back. (size)
- (5) screen 5' 194' (length) (depth to top)
2" S. steel (size) (material)
- (6) pump 1 (HP) 3 (yield gpm)
Electric (type power)
- (7) electric log NO (yes or no)
(organization running log)
- (8) how well bottom plugged 2" BWV.

description of formations encountered	from	to
Brown Clay	1	20
Chalk + sand	20	60
Shell + Clay	60	70
Chalk	70	75
Rock + Chalk	75	80
Rock	80	90
Rock + Shell	90	100
Rock	100	110
Chalk	110	115
Shell - sand - lignite	115	120
Sand	120	130
Lignite - fine sand	130	140
sand & chalk	140	185
Lignite	185	195
Sand	195	200
Sand + Chalk	200	262

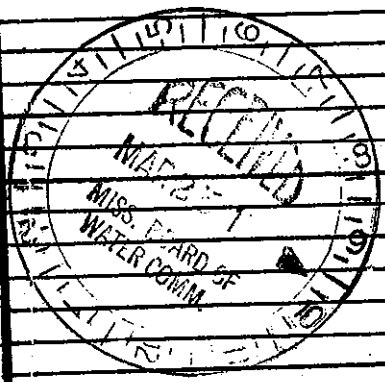

DRILLERS REMARKS: