

HINDS

MISSISSIPPI BOARD OF WATER COMMISSIONERS ELOG #237

B11

11-22-65

WATER WELL DRILLERS LOG

CODED

Date: 22 NOV, 1965, Driller: WATERWELLS, INC. County: HINDS


(Name)

Submitted by: Billy G. Cox

(1) Owner of Land:	Description & Color of Materials Sand, Clay, Red Clay, Shell, etc.	Thick- ness Feet	Depth Feet
Ralph R. Maddox (Name) R.F.D. 1, Box 80, Clinton (Address)	Clay, yellow	40.0	40
(2) Location: W 1/4, SW 1/4, Sec. 14 T. 7 R. 2,	Clay, sand & shale ledges	65	40-105
10 miles N of Clinton (distance) (direction) (Nearest Town)	Blue to grey clay & shale	44.0	105-545
(3) Topography: Hilly	shale ledges - sand fine-silty	40	545-585
(4) Purpose of Well: Domestic	Rock ledges - green clay - shale	20	585-605
(Domestic Irrigation Municipal, Industrial, Other)	Lignite (5'), hard sand - shale	80	605-685
Information upon completion of well:	Sand very fine	40	685-725
(1) Diameter: 4 1/2 inches.	sand & shale	50	725-775
(2) Total Depth: 854 feet.	Sand to shale blueish	60	775-795
(3) Water Level: 146 feet below top of ground.	Sand - fine at top - to coarse at bottom	59	795-854
(4) Cased to 273' of 567' of, Size 4" 2"			
(5) Screen: Size 2", Length 20'			
(6) Were any formations sealed against pollution?			
X yes, _____ no.			
If YES depth of formation: Surface			
Why: Health Dept. Specifications			
Drillers Remarks: Samples given			
To Miss. Geological			
Survey - Electric Log To			
706' feet.			

Top of screen 814
bottom of " 834

Pump (hp sub) set
at 190' - pumping
appx. 10 gpm

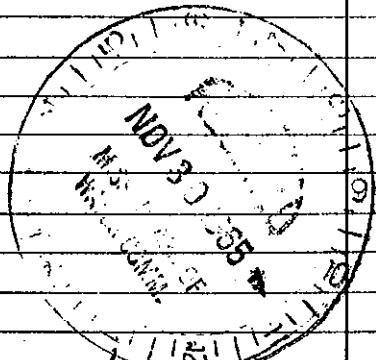

See drawing

(Use Back Side)

Well No.

Mail this copy to Board of Water Commissioners 429 Miss. St. Jackson, Miss