

HINDS MISSISSIPPI BOARD OF WATER COMMISSIONERS


B 0003
1-29-64

WATER WELL DRILLERS LOG

2

Date: JAN 29, 1964, Driller: MONEECE DRILLING County HINDS
(Name Co.)

(1) Owner of Land: <u>W.D. WILLIAMSON</u> (Name)	Description & Color of Materials Sand, Clay, Red Clay, Shell, etc.	Thick- ness Feet	Depth Feet
<u>RT 1, CLINTON MISS</u> (Address)	SURFACE Soil	6	6
(2) Location: <u>SE</u> $\frac{1}{4}$, <u> </u> $\frac{1}{4}$, Sec. <u>24</u> T <u>7N</u> R <u>2W</u>	WHITE SHALE	24	30
<u>4</u> miles <u>SW</u> of <u>POCOHONTAS</u> (distance) (direction) (Nearest Town)	WHITE SAND	8	38
(3) Topography: <u>HILLY</u> (Hilly) (Flat) (Level)	GREY SHALE	470	508
(4) Purpose of Well: <u>MINNOW FARM</u> (Domestic Irrigation Municipal, Industrial, Other)	MOODYS BRANCH	21	529
Information upon completion of well:	SANDY SHALE	20	549
(1) Diameter <u>4x2 1/2</u> inches.	" "	147	696
(2) Total Depth <u>850</u> feet.	SHALE	34	730
(3) Water Level <u>136</u> feet below top of ground.	SAND & SHALE	66	798
(4) Cased to <u>350'</u> 819' Size <u>4"</u> <u>350' to 850' - 2 1/2"</u>	SAND	8	804
(5) Screen: Size <u>2 1/2</u> , Length <u>40'</u>	SAND & SHALE	47	777
(6) Were any formations sealed against pollution? _____ yes, <u>X</u> no.	SAND	77	854
If YES depth of formation _____			
Why _____			
Drillers Remarks: _____			

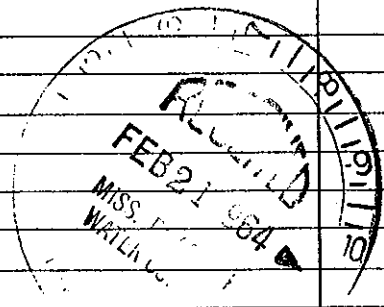

Well No. 609

(Use Back Side)

Mail this copy to Board of Water Commissioners 429 Miss. St. Jackson, Miss.