

HINDS MISSISSIPPI BOARD OF WATER COMMISSIONERS


B 7004
10-21-64

WATER WELL DRILLERS LOG

Hinds

Date: 10/21, 1964, Driller: Frank Dooling County: Scott
(Name)

(1) Owner of Land	Description & Color of Materials Sand, Clay, Red Clay, Shell, etc.	Thick- ness Feet	Depth Feet
C. W. Martin (Name)	Brown Clay	0	18
Rt 1 Bolton, Miss. (Address)	Brown Limestone		19
(2) Location: 1/4, 1/4, Sec. 21, T 71 N, R 20 W	Chalky Clay & Limestone		60
North of Bolton, Miss. (distance) (direction) (Nearest Town)	Rock		62
(3) Topography: (Hilly) (Flat) (Level)	Rock & Limestone		110
(4) Purpose of Well: Home (Domestic Irrigation, Municipal, Industrial, Other)	Blue Clay		147
	Shale & 1st Sand		153
	Blue Clay		194
	Light 1st Shale		202
	Blue Clay		210
	Light 1st Shale		220
	Limestone		283
			207
			207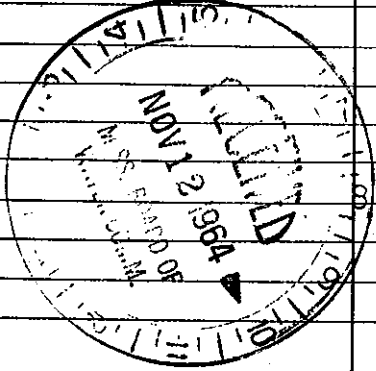
Well No.

(Use Back Side)

Mail this copy to Board of Water Commissioners 429 Miss. St. Jackson, Miss